


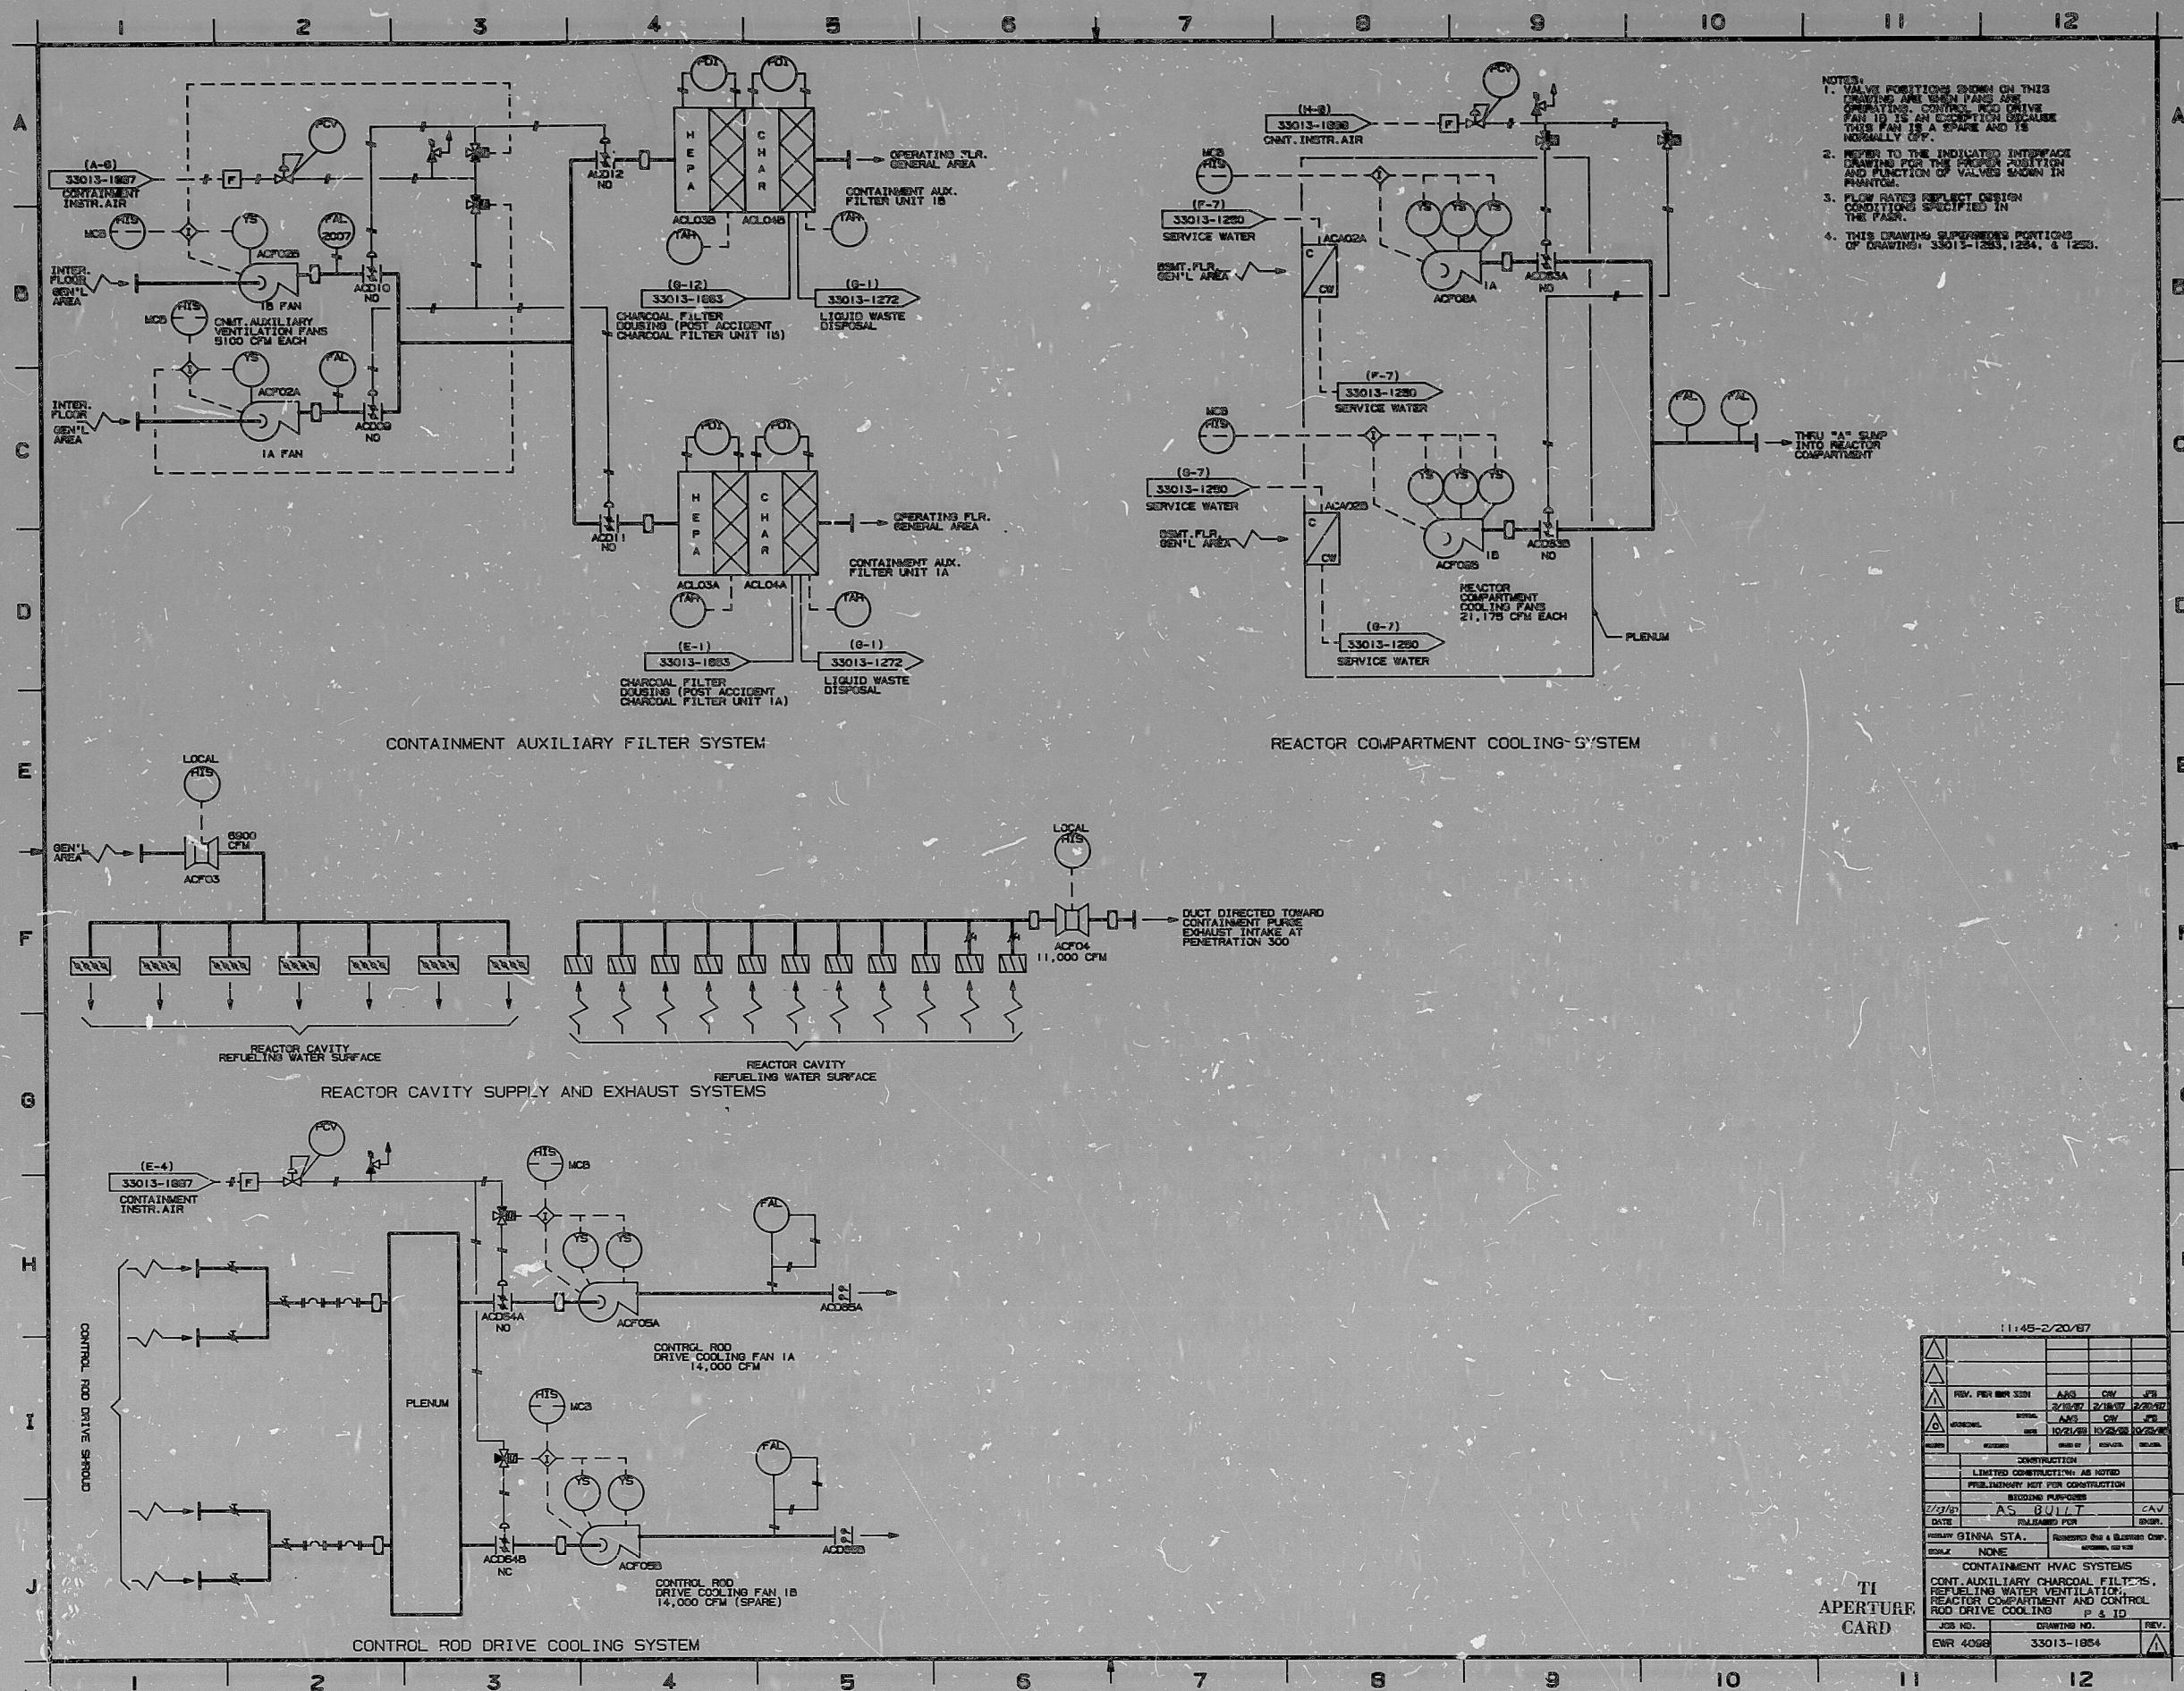

PDR RIDS

87L0220395

