


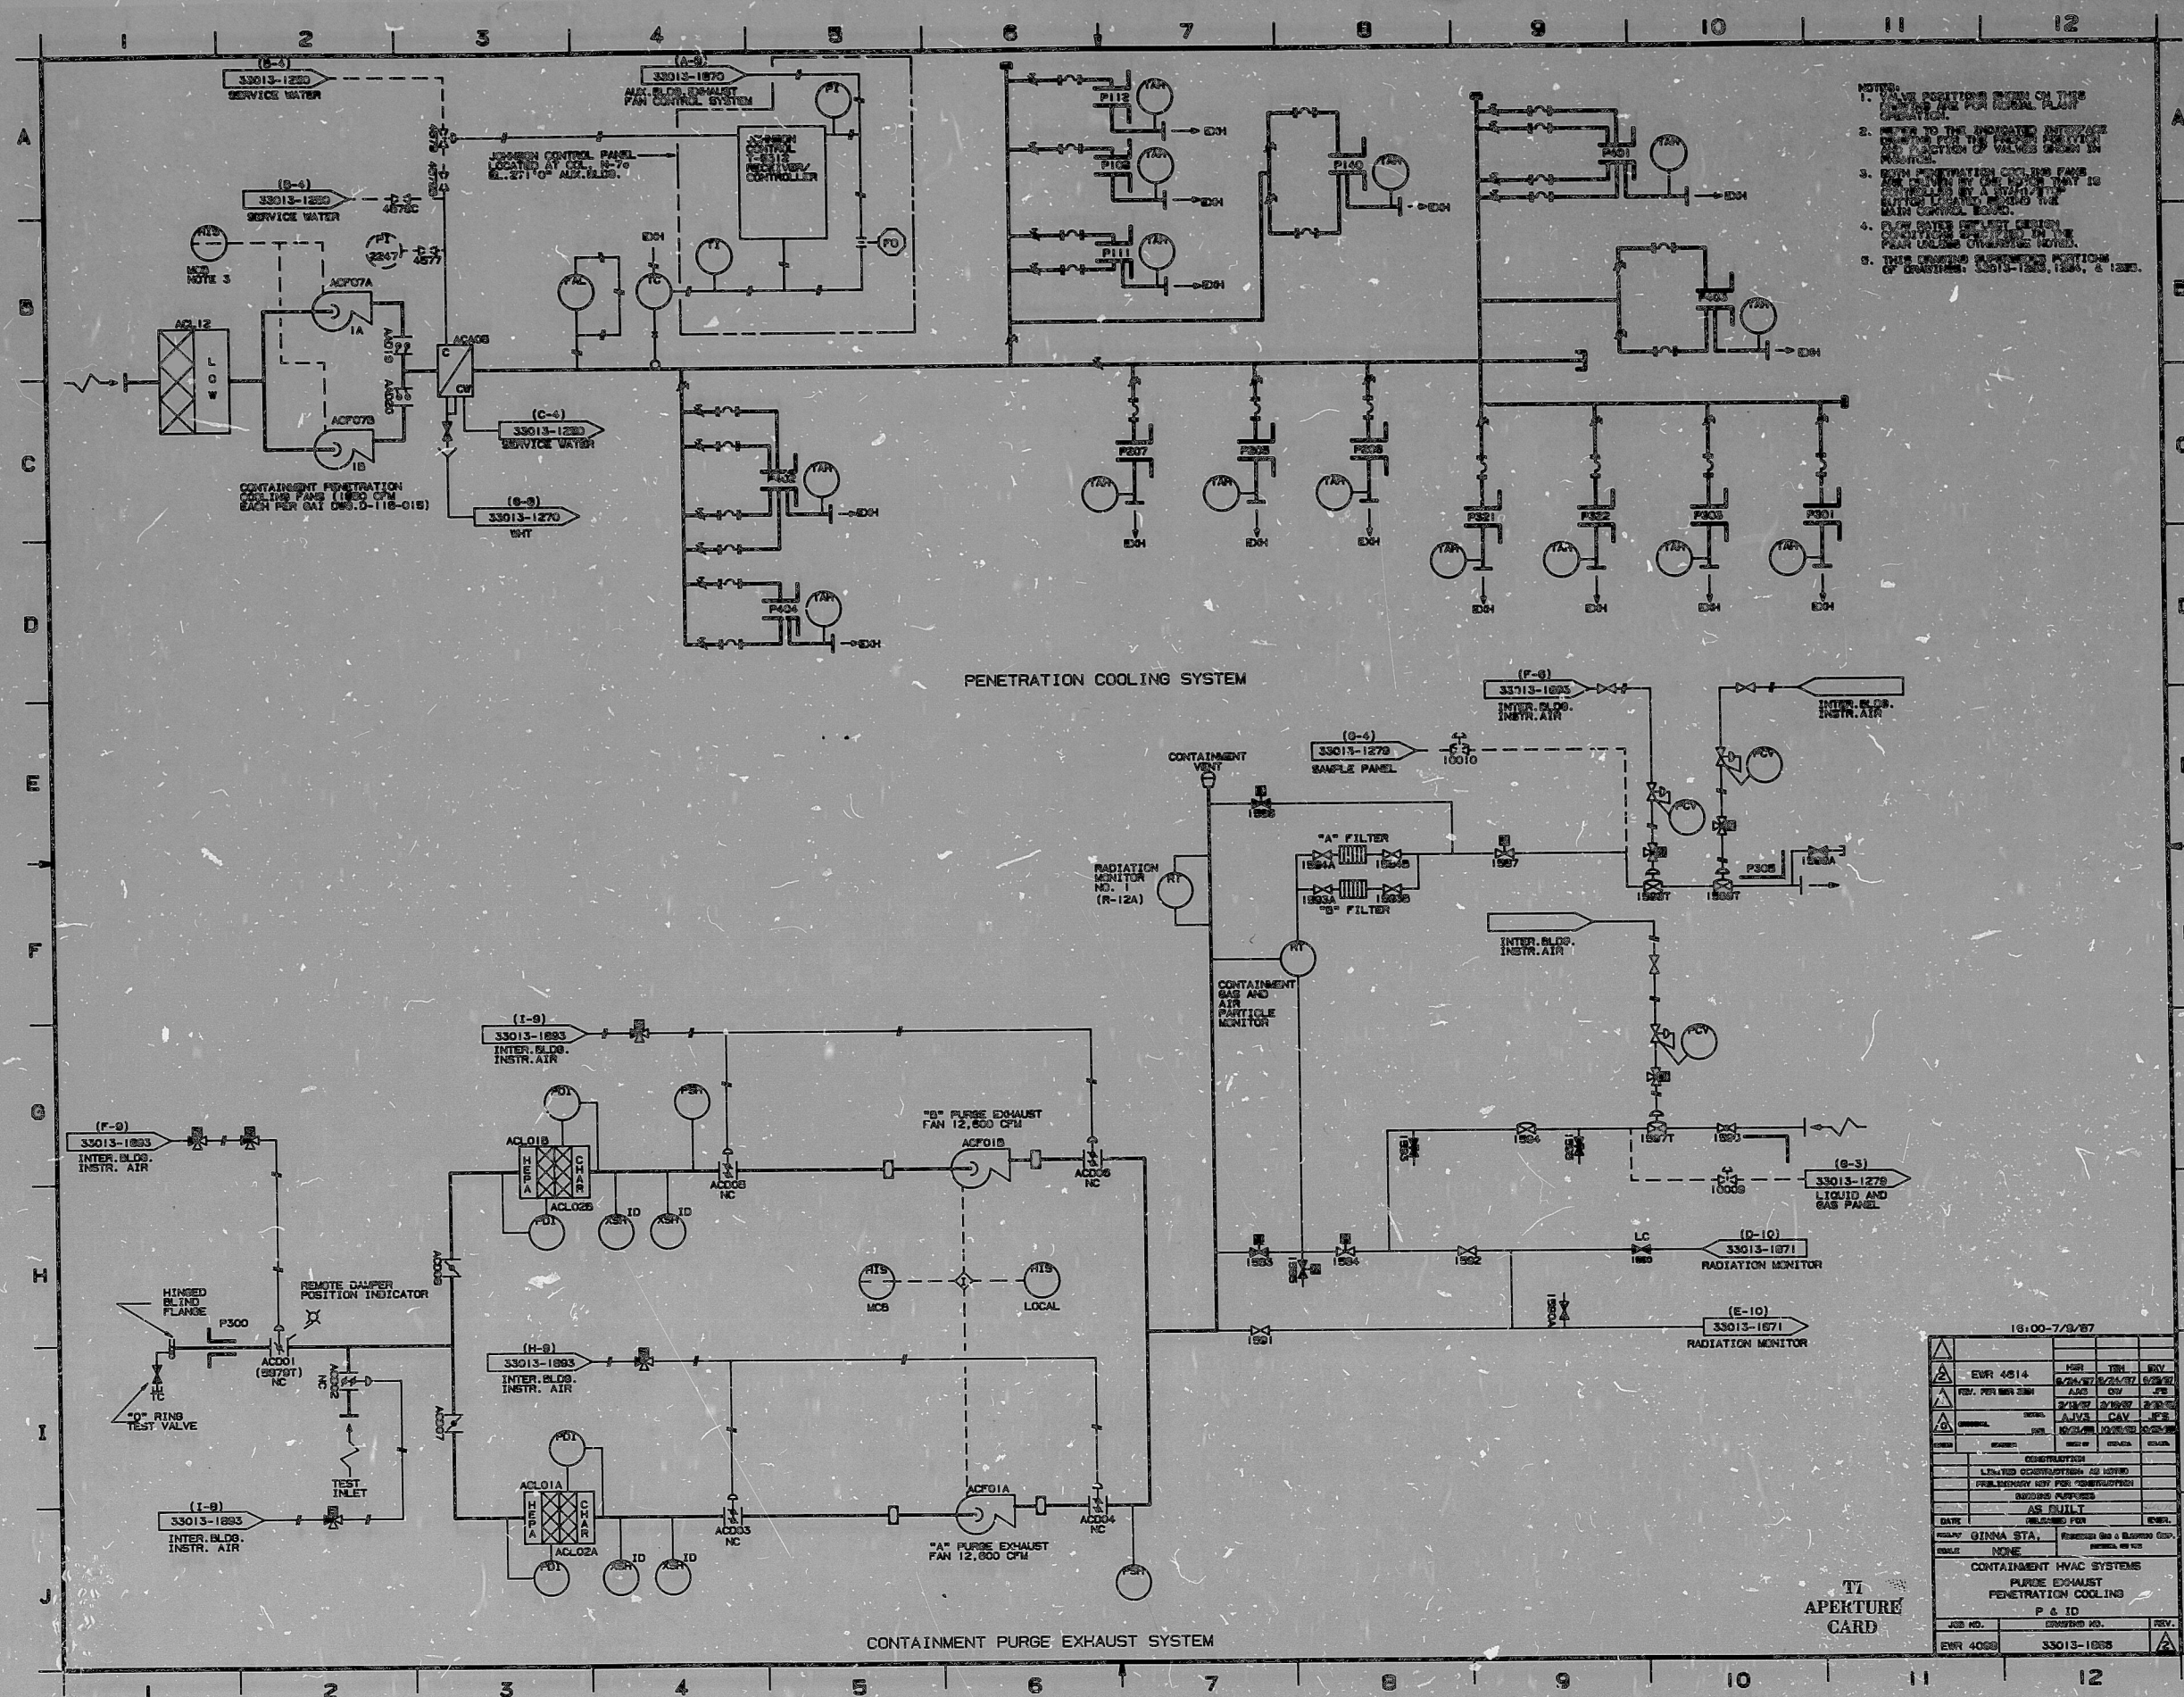

PDR RIDS

87 L0220402

