


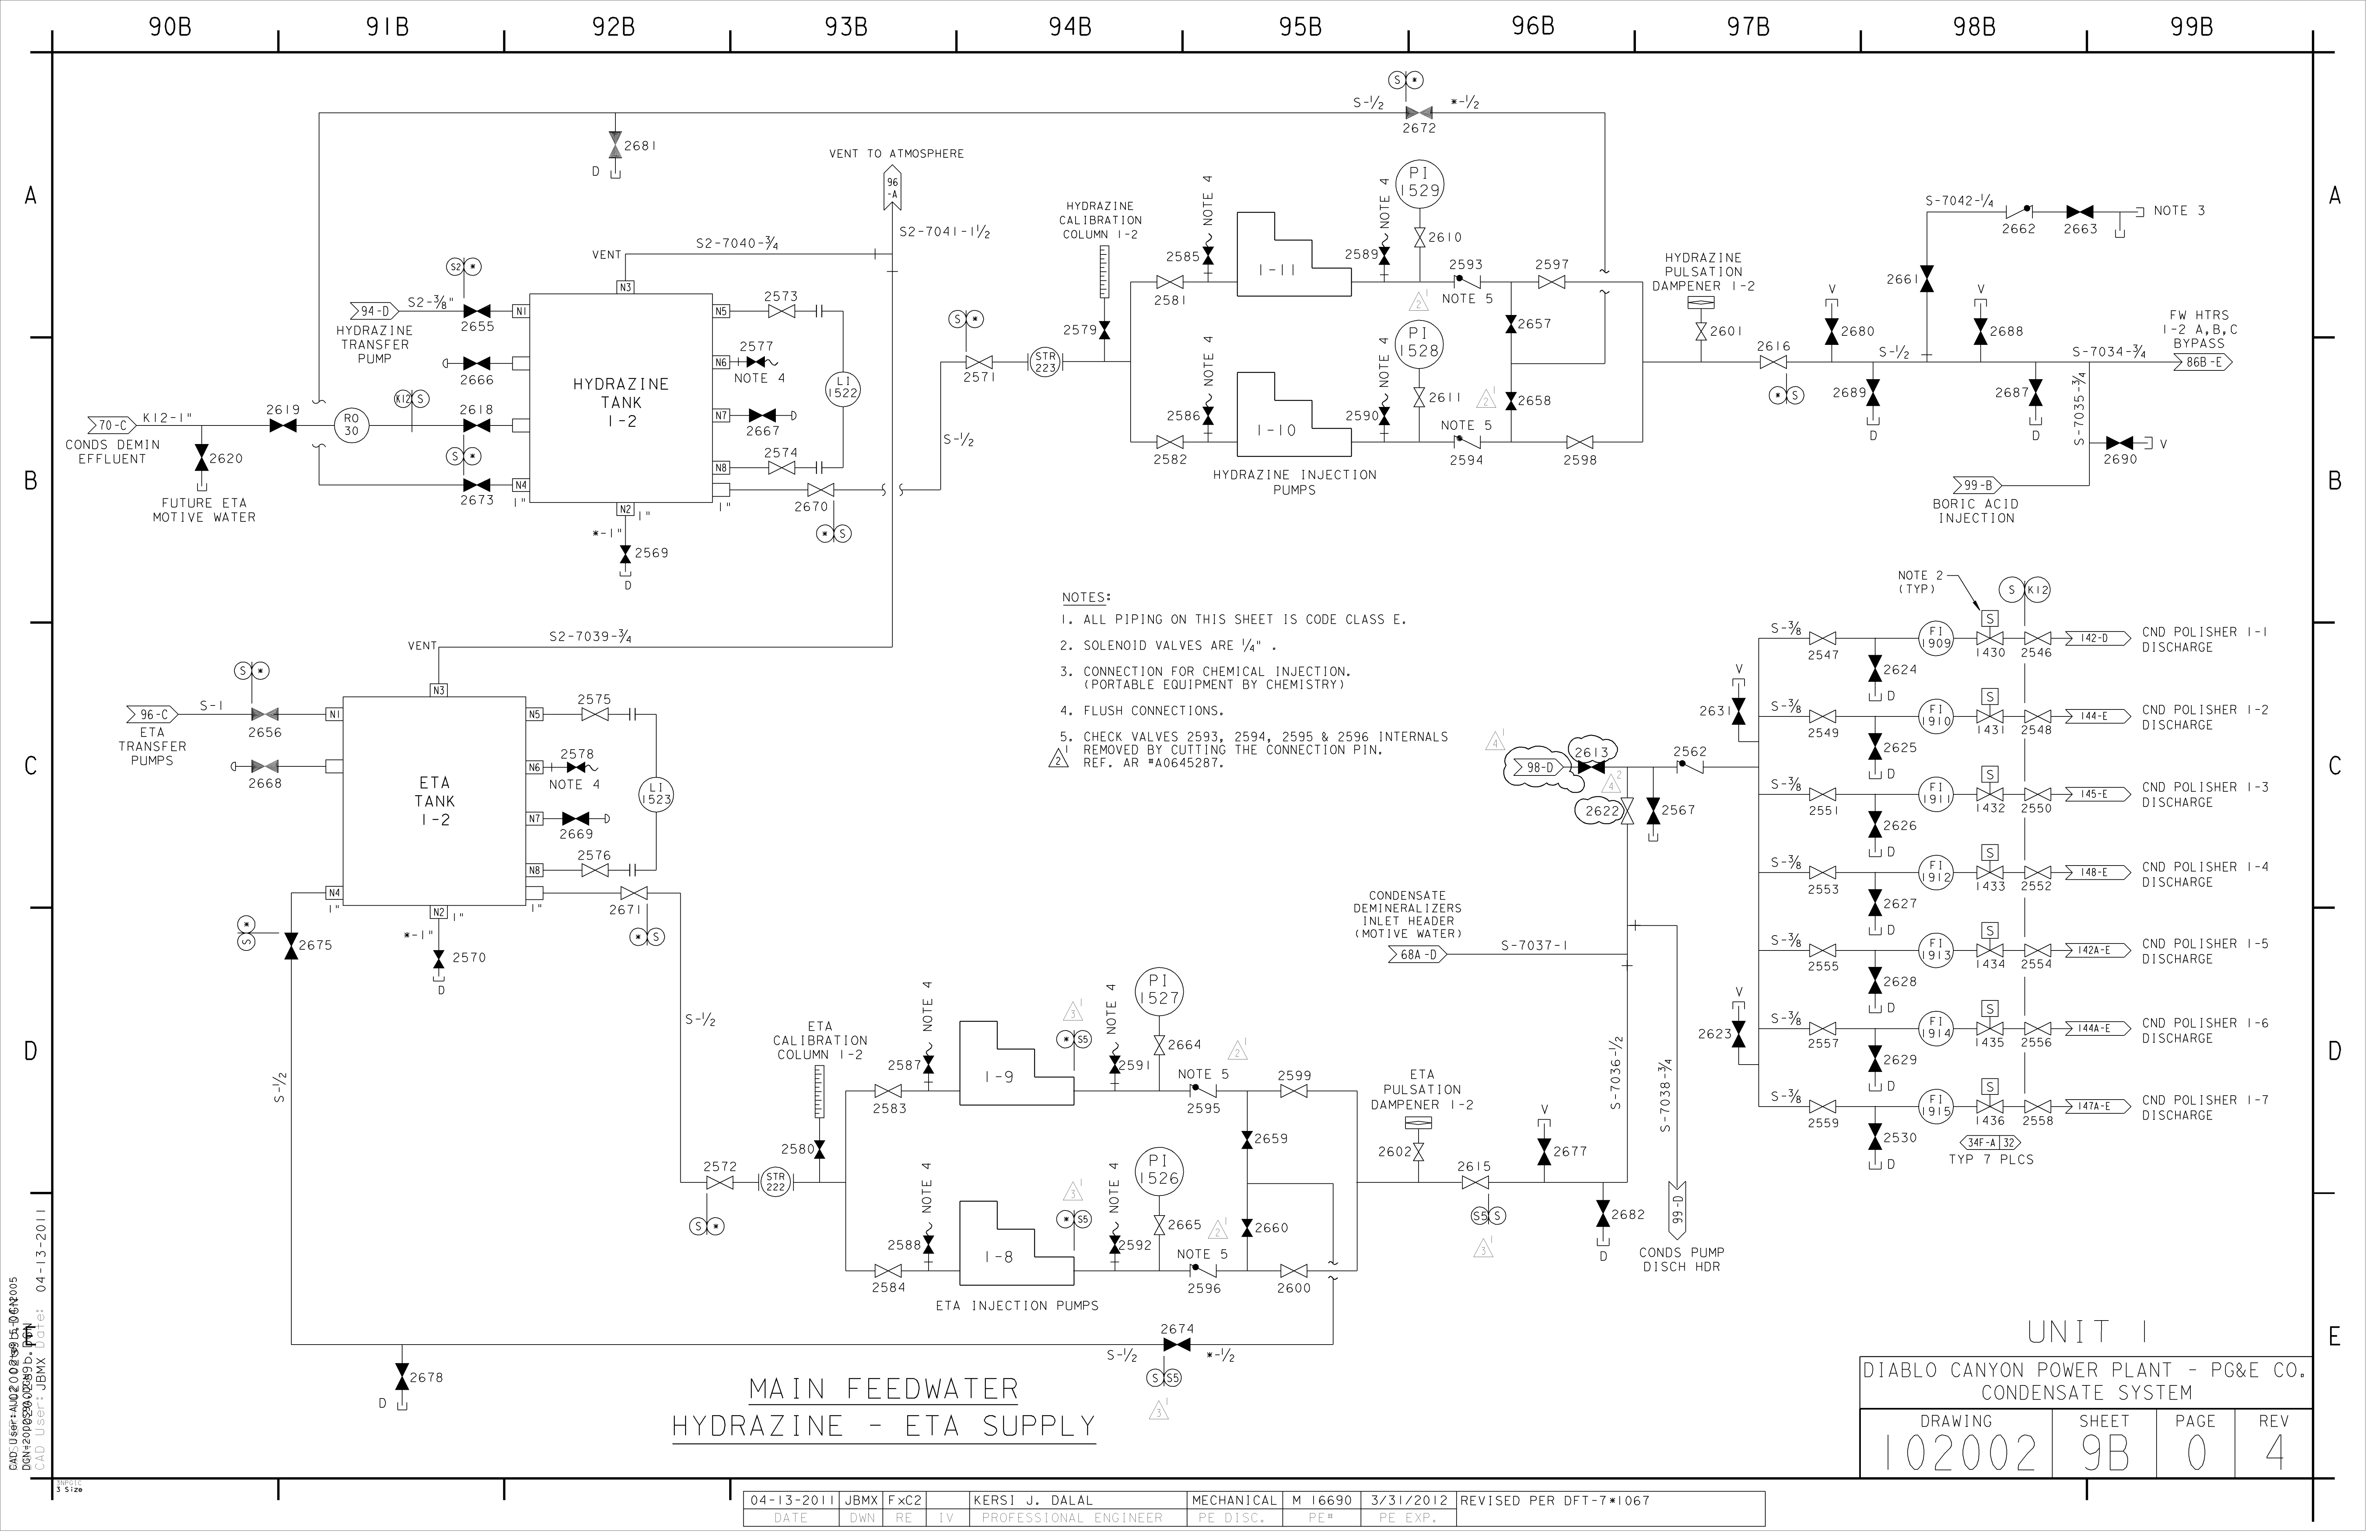

- NOTES:
1. ALL PIPING ON THIS SHEET IS CODE CLASS E.
 2. SOLENOID VALVES ARE 1/4" .
 3. CONNECTION FOR CHEMICAL INJECTION.
(PORTABLE EQUIPMENT BY CHEMISTRY)
 4. FLUSH CONNECTIONS.
 5. CHECK VALVES 2593, 2594, 2595 & 2596 INTERNALS
REMOVED BY CUTTING THE CONNECTION PIN.
REF. AR #A0645287.

UNIT 1			
DIABLO CANYON POWER PLANT - PG&E CO. CONDENSATE SYSTEM			
DRAWING	SHEET	PAGE	REV
102002	9B	0	4

04-13-2011	JBMX	FxC2		KERSI J. DALAL	MECHANICAL	M 16690	3/31/2012	REVISED PER DFT-7*1067
DATE	DWN	RE	IV	PROFESSIONAL ENGINEER	PE DISC.	PE#	PE EXP.	