


E
D
C
B
A

E
D
C
B
A

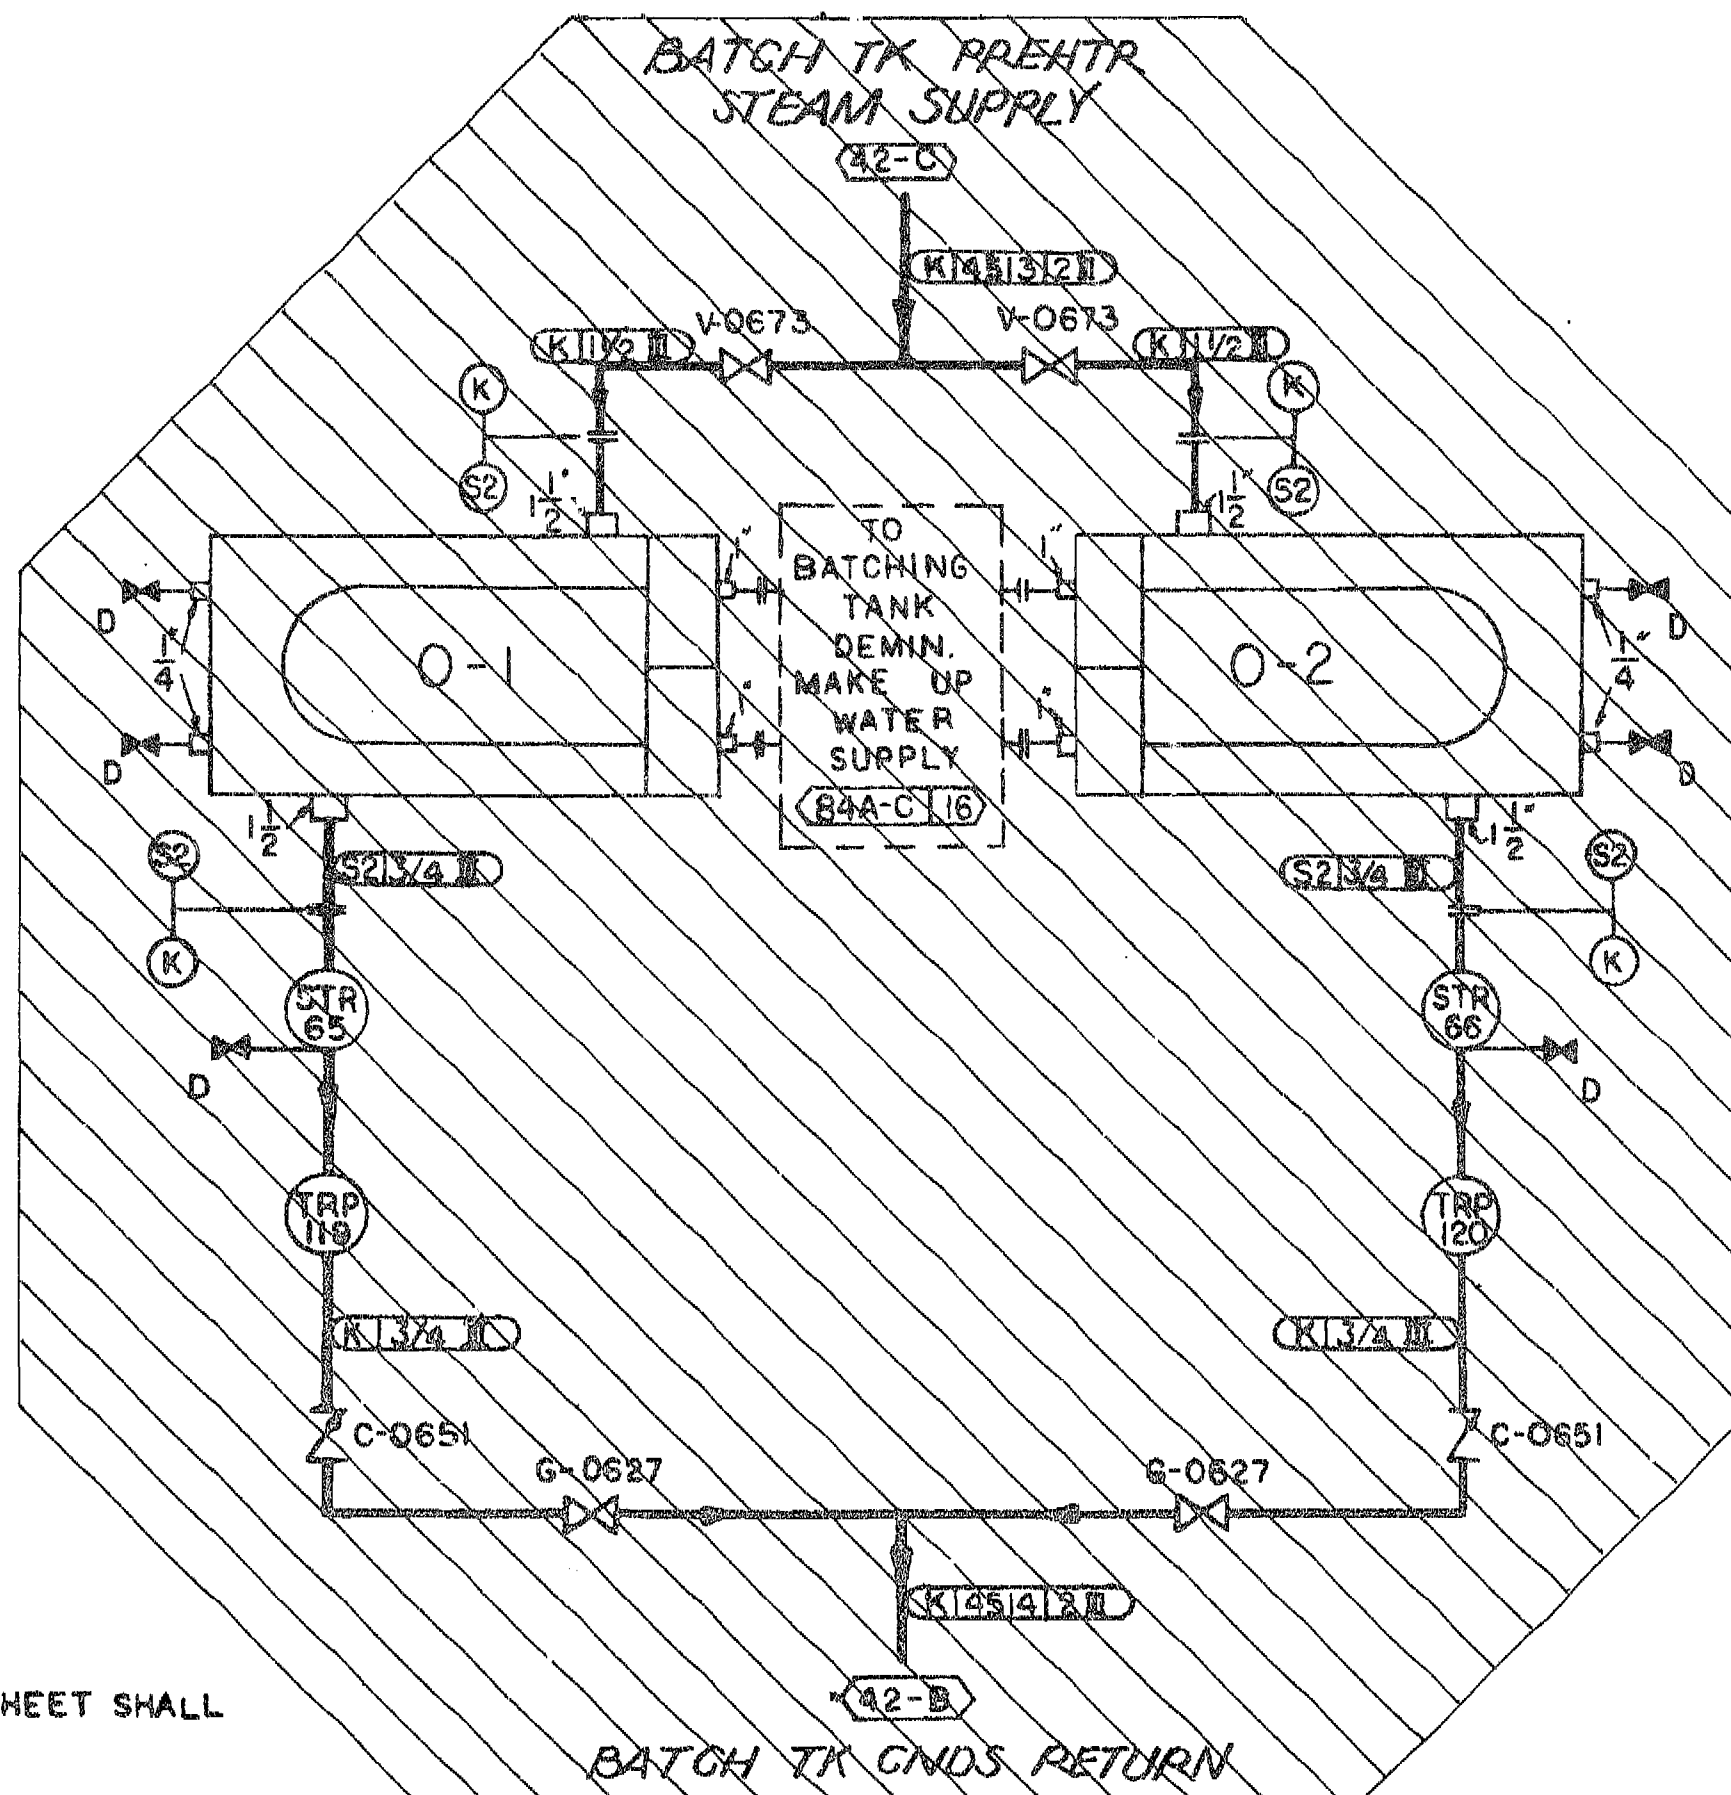

NOTE:
ALL PIPING IN THIS SHEET SHALL
BE PG&E CLASS [E]

B. A. BATCHING TANK WATER PREHEATER

UNIT - 2

P.G. & E. CO.	DRAWING	REVISION
SHEET 4A OF SHEETS	108006	10
	MICROFILM	10