


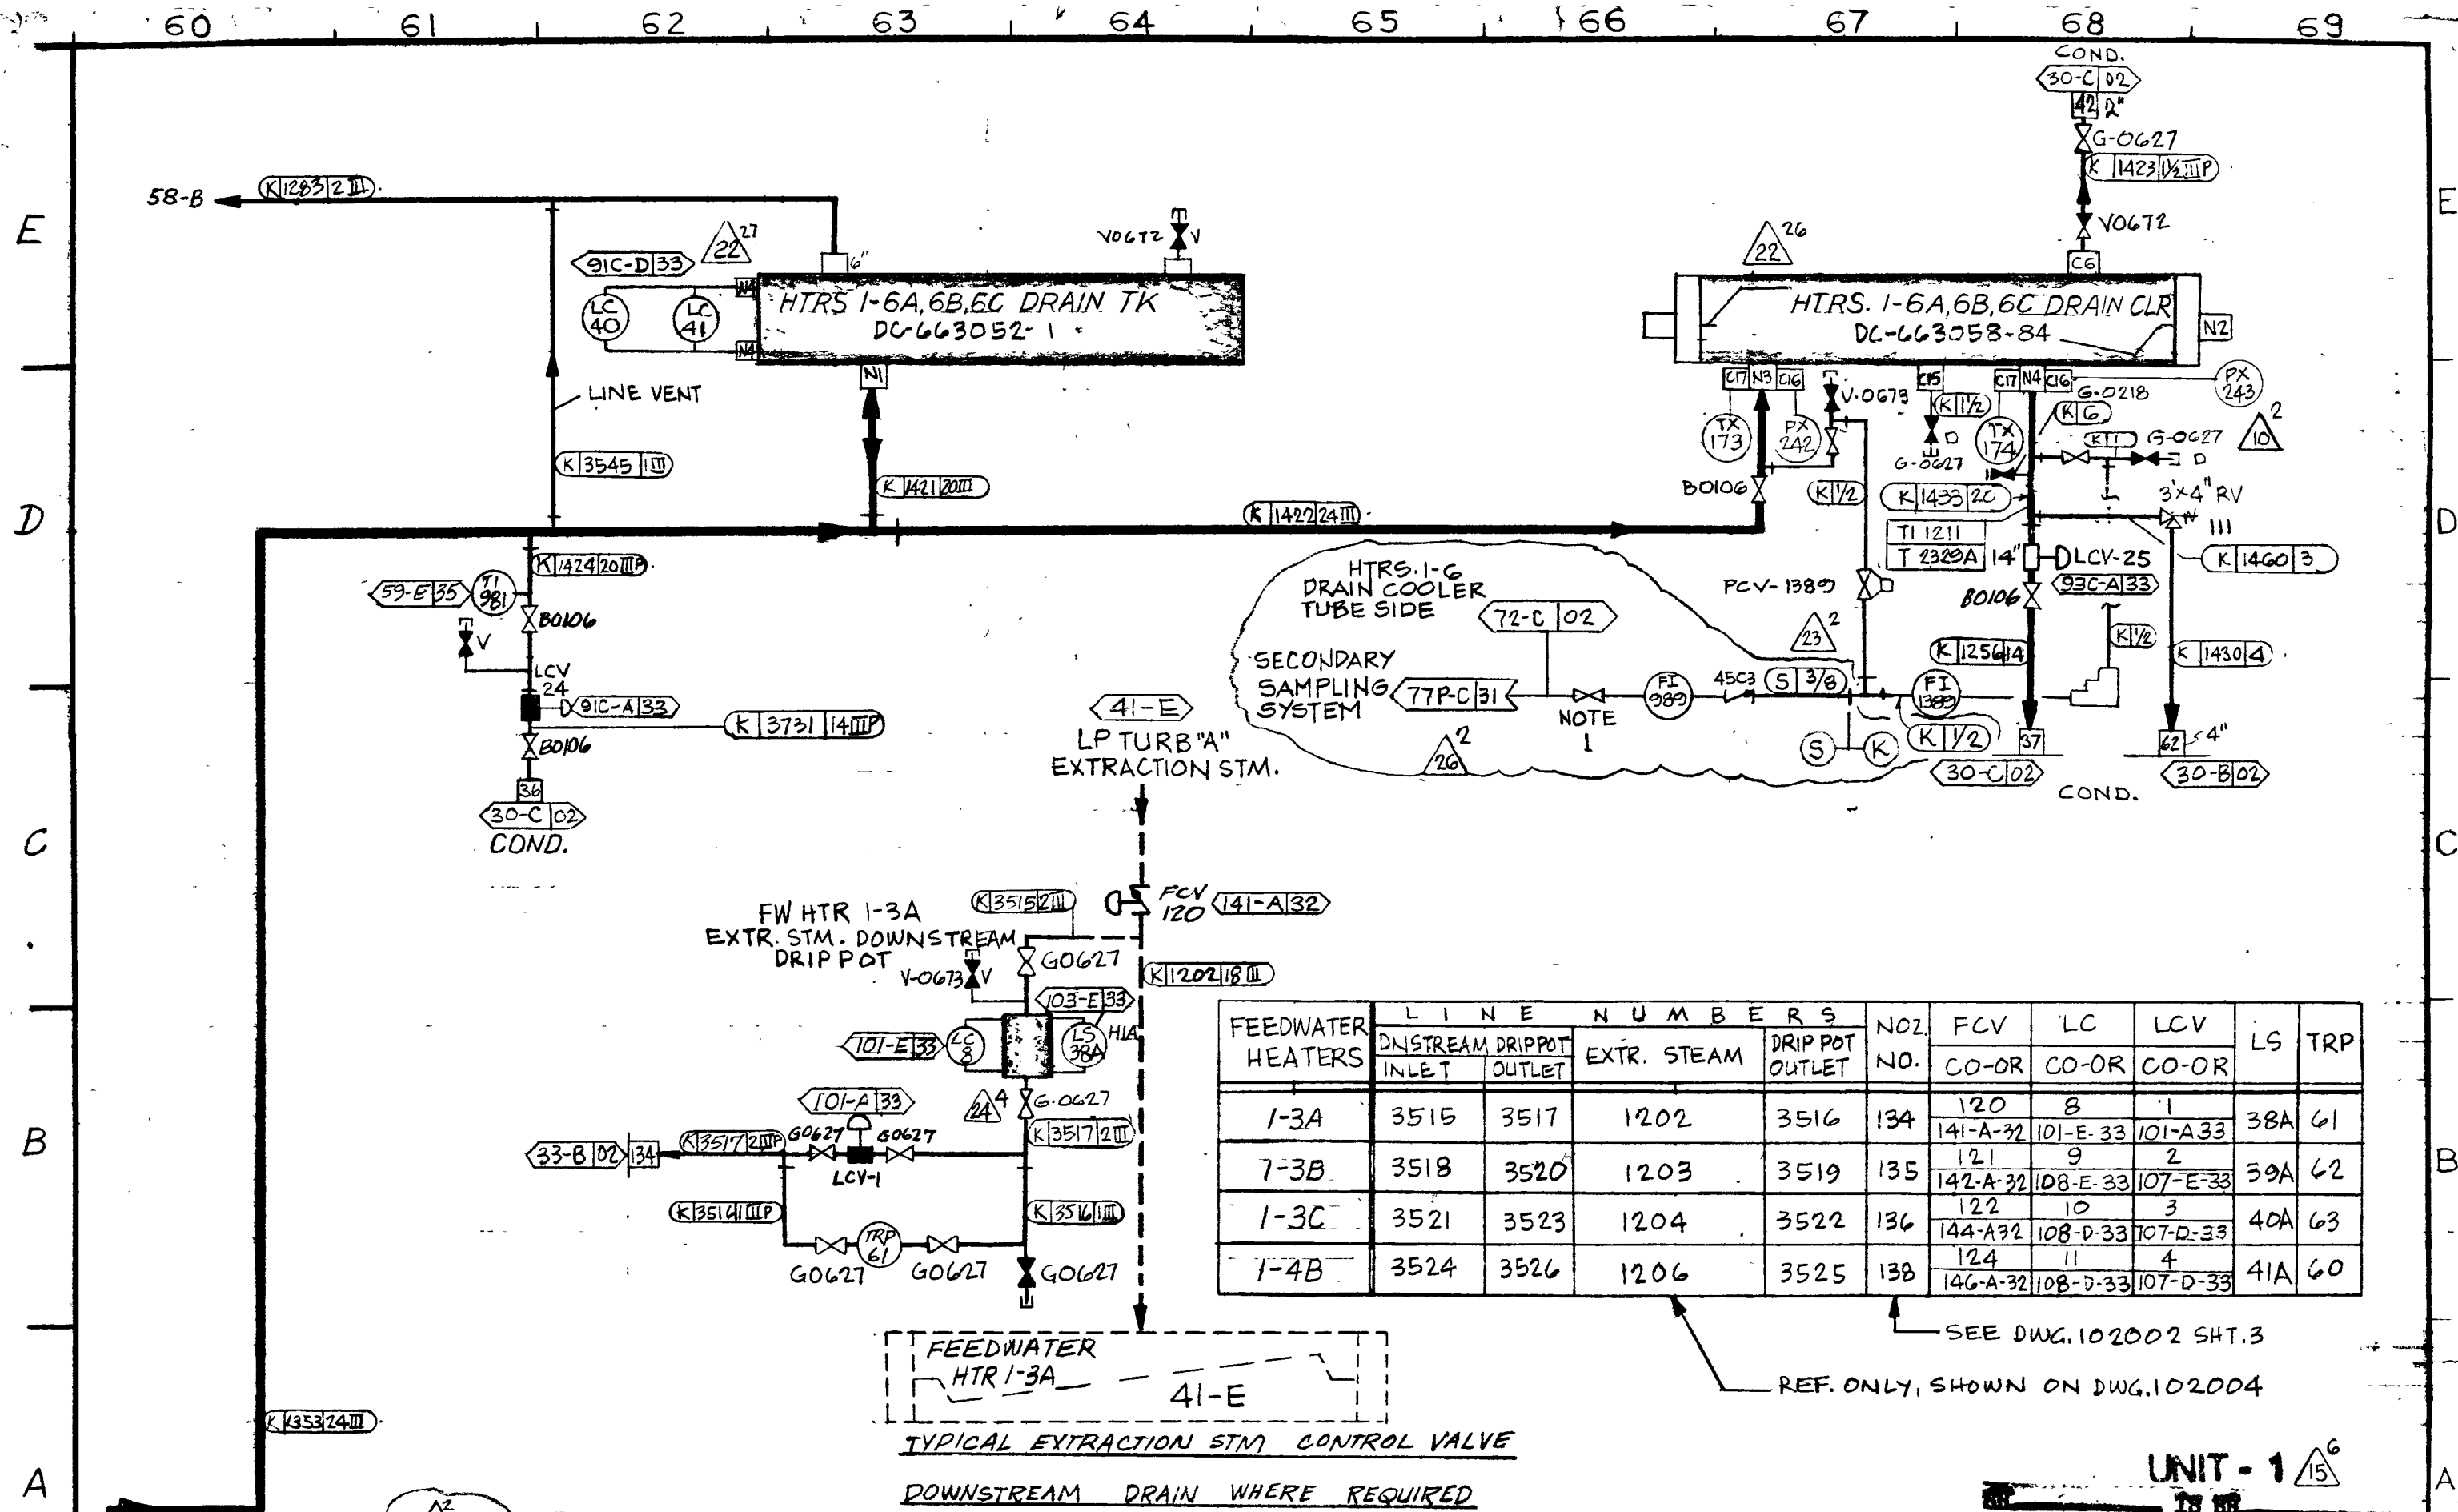

SCAN 26 IC

RM INDEXED REV 24

P.G.&E.CO.

SHEET NO. 6 OF SHEETS

DRAWING NUMBER **102005**

CHANGE 26