


E
D
C
B
A

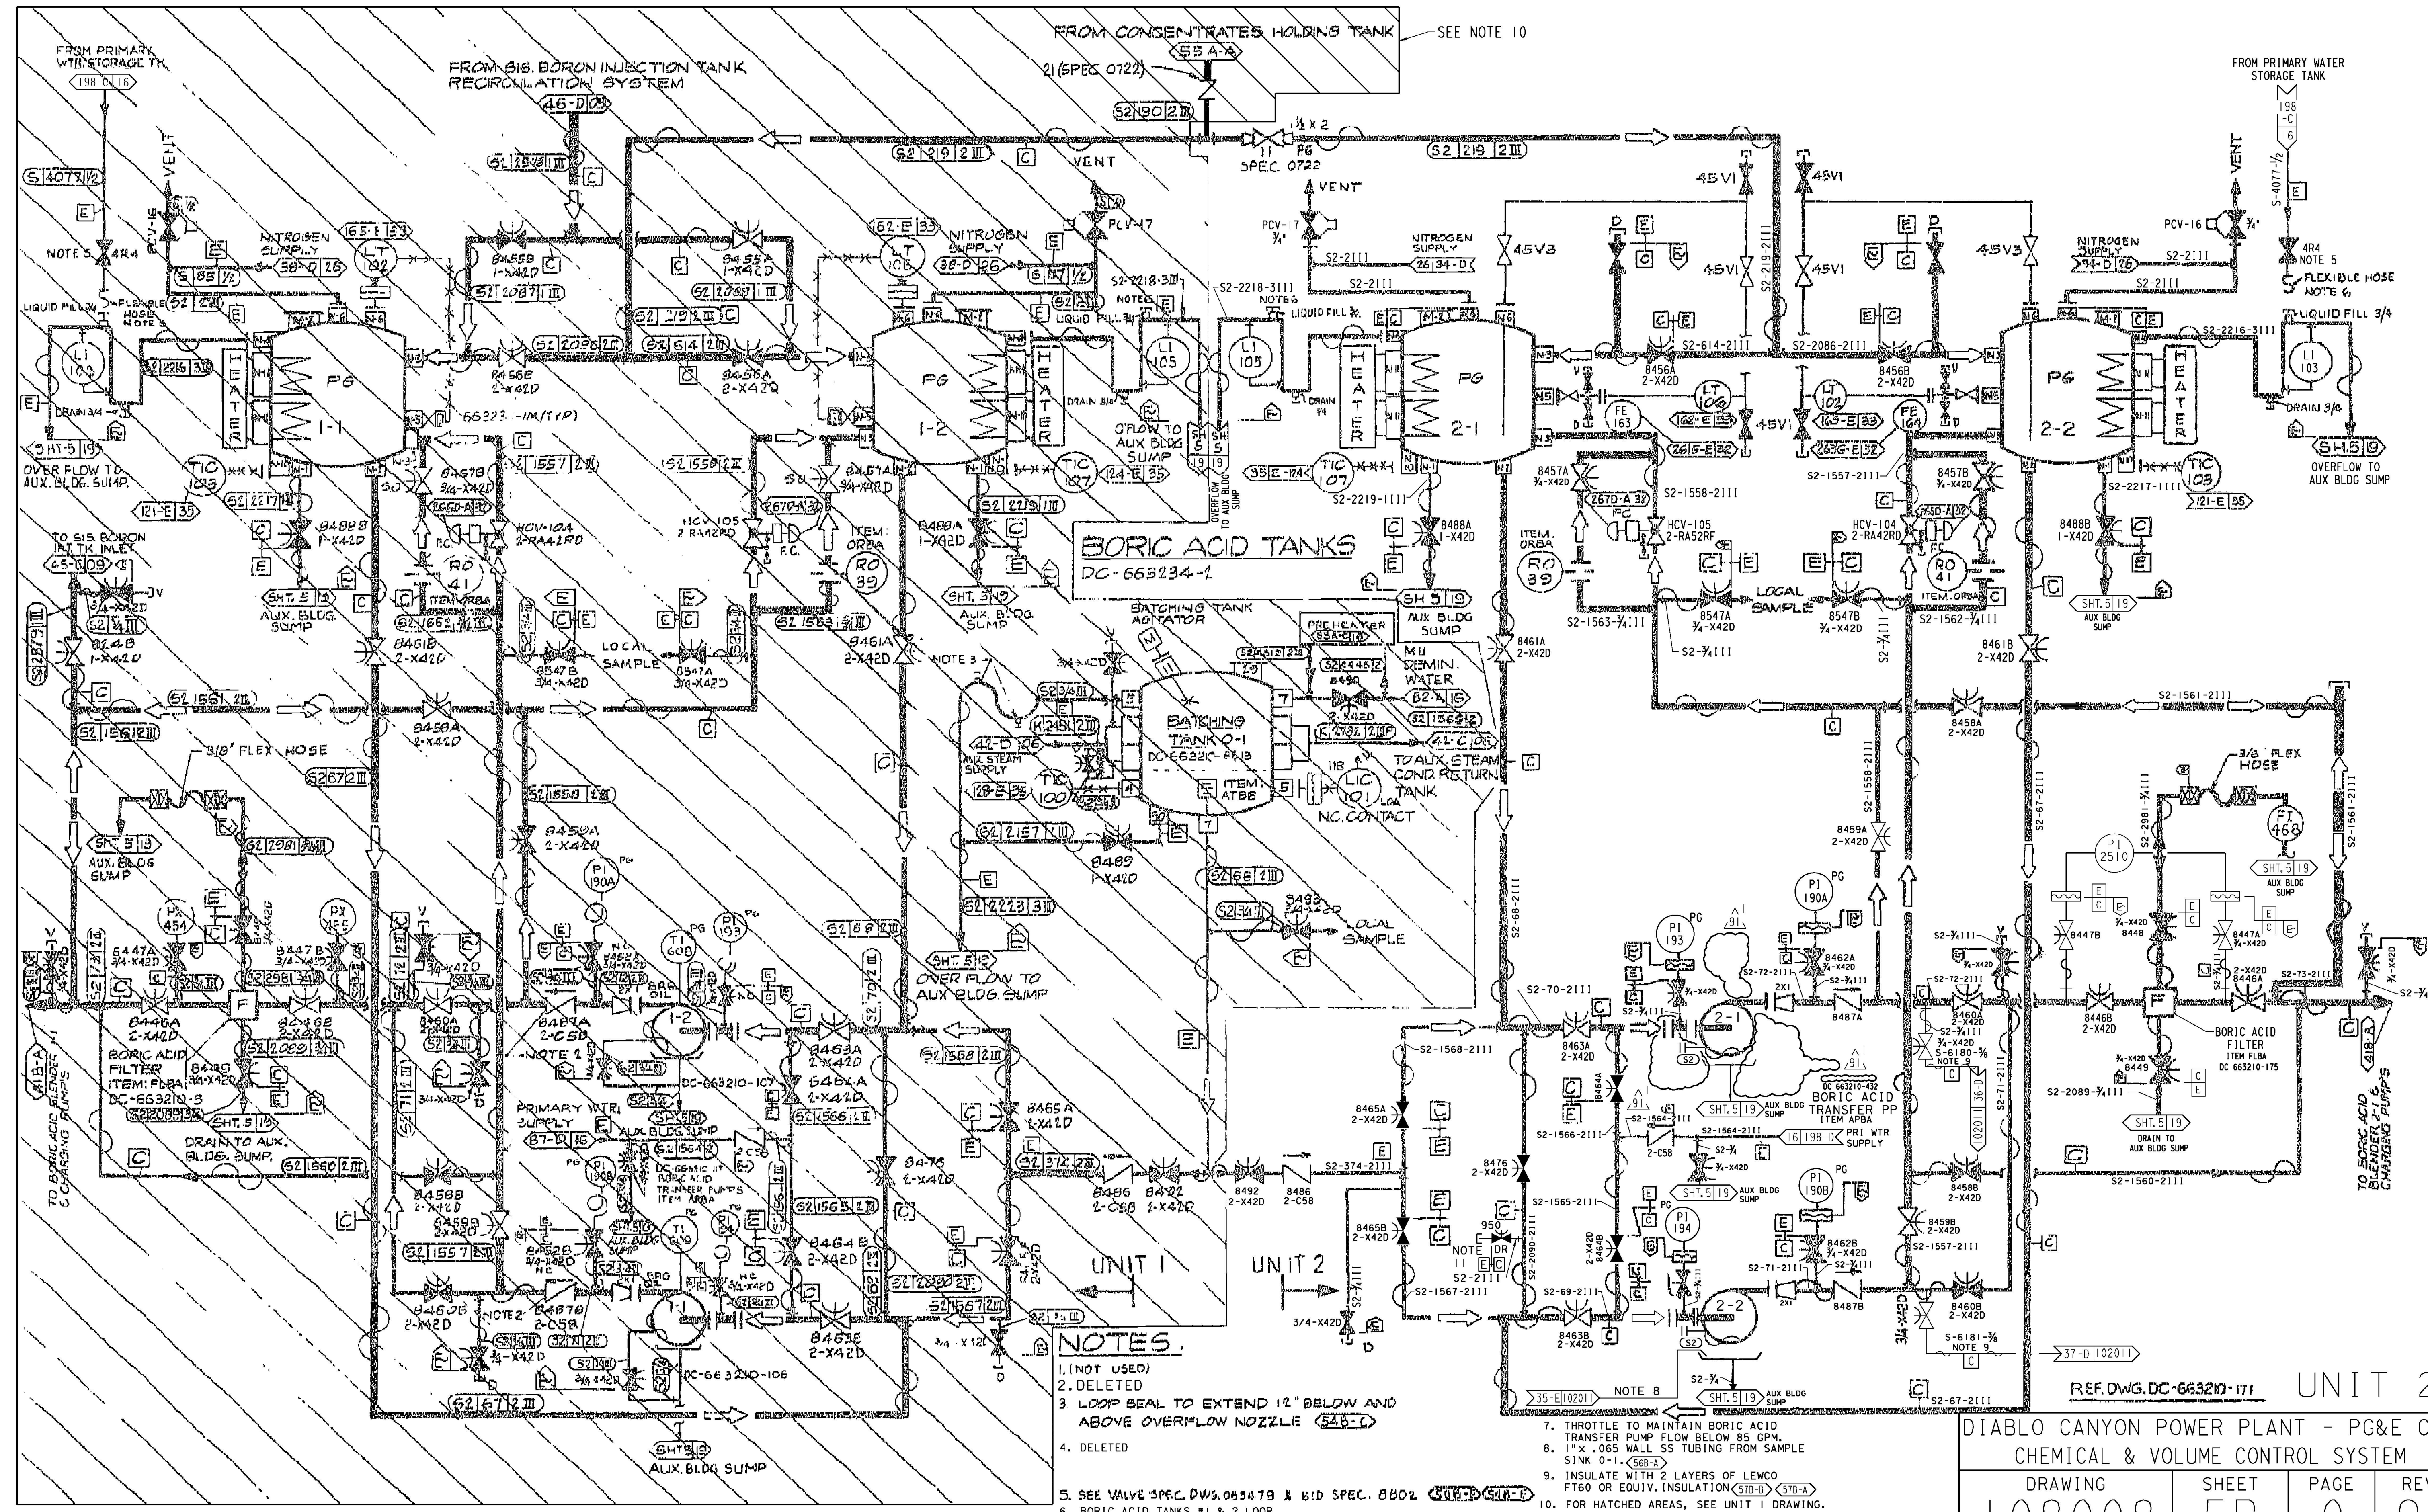

NOTES

- 1. (NOT USED)
- 2. DELETED
- 3. LOOP SEAL TO EXTEND 12" BELOW AND ABOVE OVERFLOW NOZZLE (54B-C)
- 4. DELETED
- 5. SEE VALVE SPEC. DWG. 063479 & BID SPEC. 8802 (50B-B-54B-E)
- 6. BORIC ACID TANKS #1 & 2 LOOP SEALS ARE SERVICED BY A COMMON FLEXIBLE HOSE (50B-D)
- 7. THROTTLE TO MAINTAIN BORIC ACID TRANSFER PUMP FLOW BELOW 85 GPM.
- 8. 1" x .065 WALL SS TUBING FROM SAMPLE SINK 0-1. (56B-A)
- 9. INSULATE WITH 2 LAYERS OF LEWCO FT60 OR EQUIV. INSULATION (57B-E) (57B-A)
- 10. FOR HATCHED AREAS, SEE UNIT 1 DRAWING.
- 11. CONNECTION POINT FOR FLEX EQUIPMENT. (57B-B)

DIABLO CANYON POWER PLANT - PG&E CO.
CHEMICAL & VOLUME CONTROL SYSTEM

DRAWING	SHEET	PAGE	REV
108008	5B	0	91

RASTER=108008-5B-0.dgn
DCN=108008-5B-0.dgn
CAD User: ZNS4 Date: 06-19-2019

06-19-2019	ZNS4	FXC2	N/A	NOT REQUIRED PER CF3.1D5	-	-	-	Revised Per DDN-2*1883
DATE	DWN	RE	IV	PROFESSIONAL ENGINEER	PE DISC.	PE#	PE EXP.	DFT-7*4887