

70

71

72

73

74

75

76

77

78

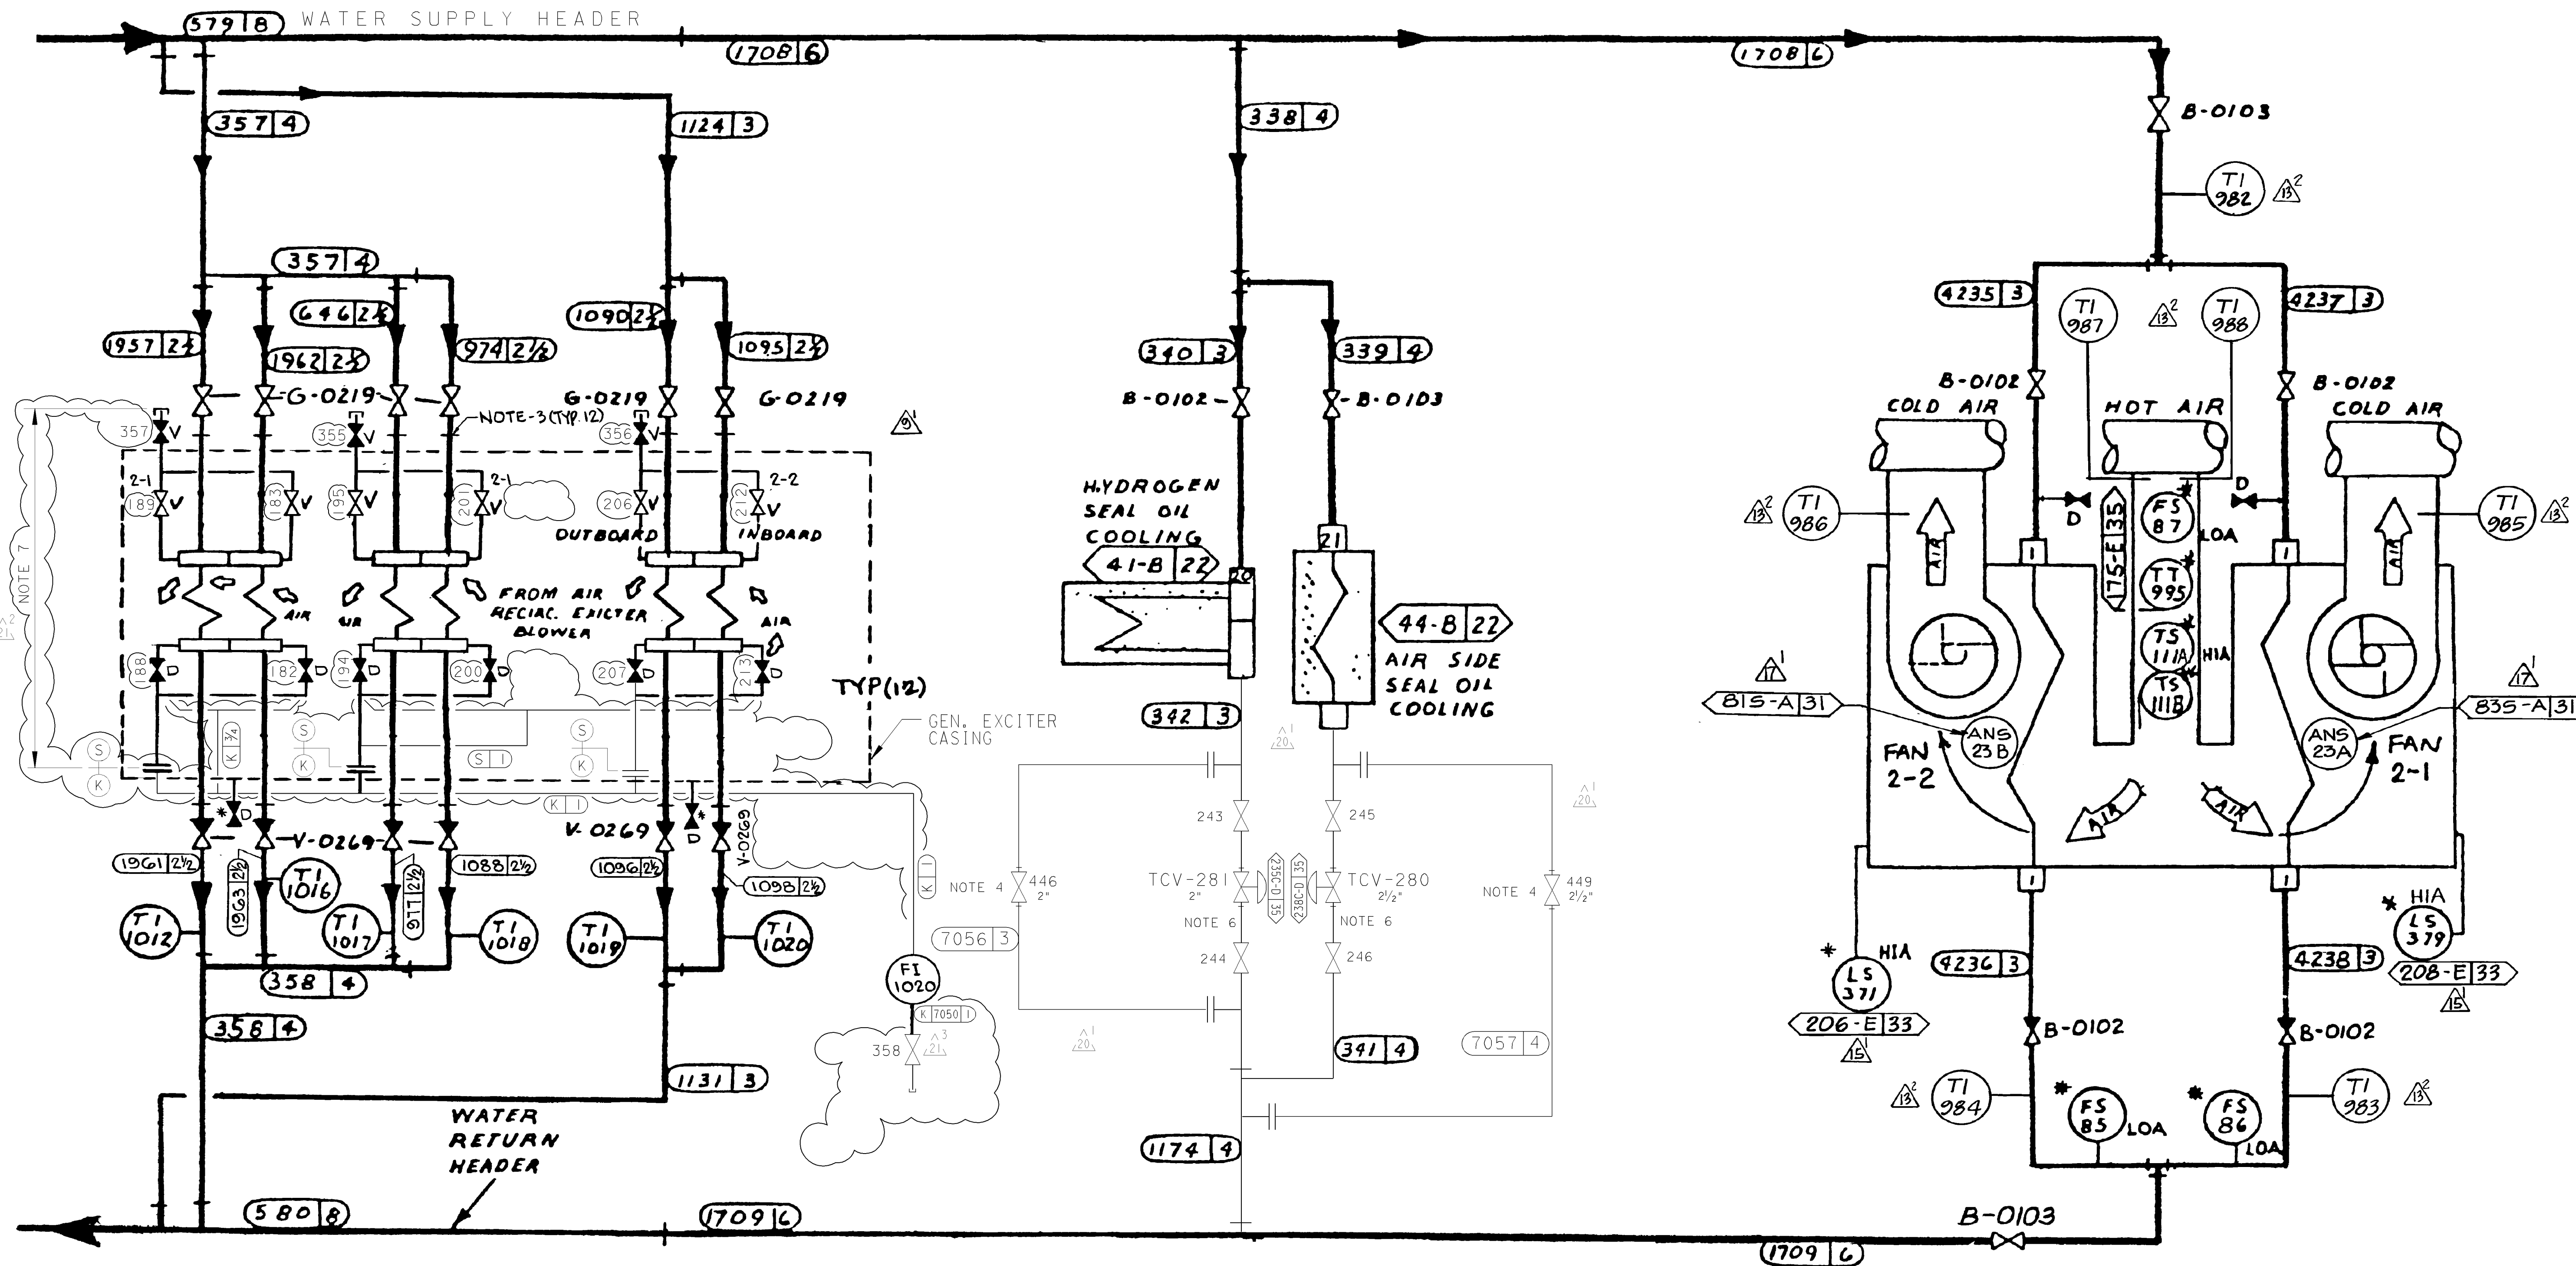
79

E

D

C

B

RASTER=8015.s7, dgn
DCN=8015.s7, dgn
CAD User: FAZI Date: 04-10-2008

DC-663293-1 DC-663293-1 DC-663282-30 DC-663326-55
GENERATOR EXCITER FUSE WHEEL GENERATOR SEAL OIL COOLERS ISO-PHASE BUS COOLERS
2 COILS PER COOLER 2 COILS PER COOLER 1 COIL PER COOLER

- NOTES: 1. PIPING LINE DESIGNATION NO'S TO BE "K" SPEC.
2. ALL PIPING THIS SHEET SHALL BE PG&E CLASS "E".
3. "VICTAULIC" TYPE COUPLING TYP. OF 12. SEE DC 663293-1 71-D
4. FISHER CLASS 150 RF FLANGED WITH 1008/40 ACTUATOR. 2" S.C. 78-9003. 2 1/2" S.C. 78-9002. 193
5. 3" BTFV VALVE S.C. 75-5546. 4" BTFV VALVE S.C. 72-9649. 18
6. THE REDUCERS ARE 4" x 2 1/2" AND 3" x 2" REDUCING ELBOWS. (REF. A0610663) 19
7. SS TUBING FOR COOLER VENTS AND DRAINS BY PG&E; SEE N-MOD A0703483. 21

UNIT 2

DIABLO CANYON POWER PLANT - PG&E CO.
SERVICE COOLING WATER SYSTEM

DRAWING	SHEET	PAGE	REV
108015	7	0	21

04-10-2008	FAZI	FxC2		KERSI J. DALAL	MECHANICAL	M 16690	3/31/2010	REVISED PER DC2-SM-50841-00
DATE	DWN	RE	IV	PROFESSIONAL ENGINEER	PE DISC.	PE#	PE EXP.	, FCT-32707 & FCT-33530