


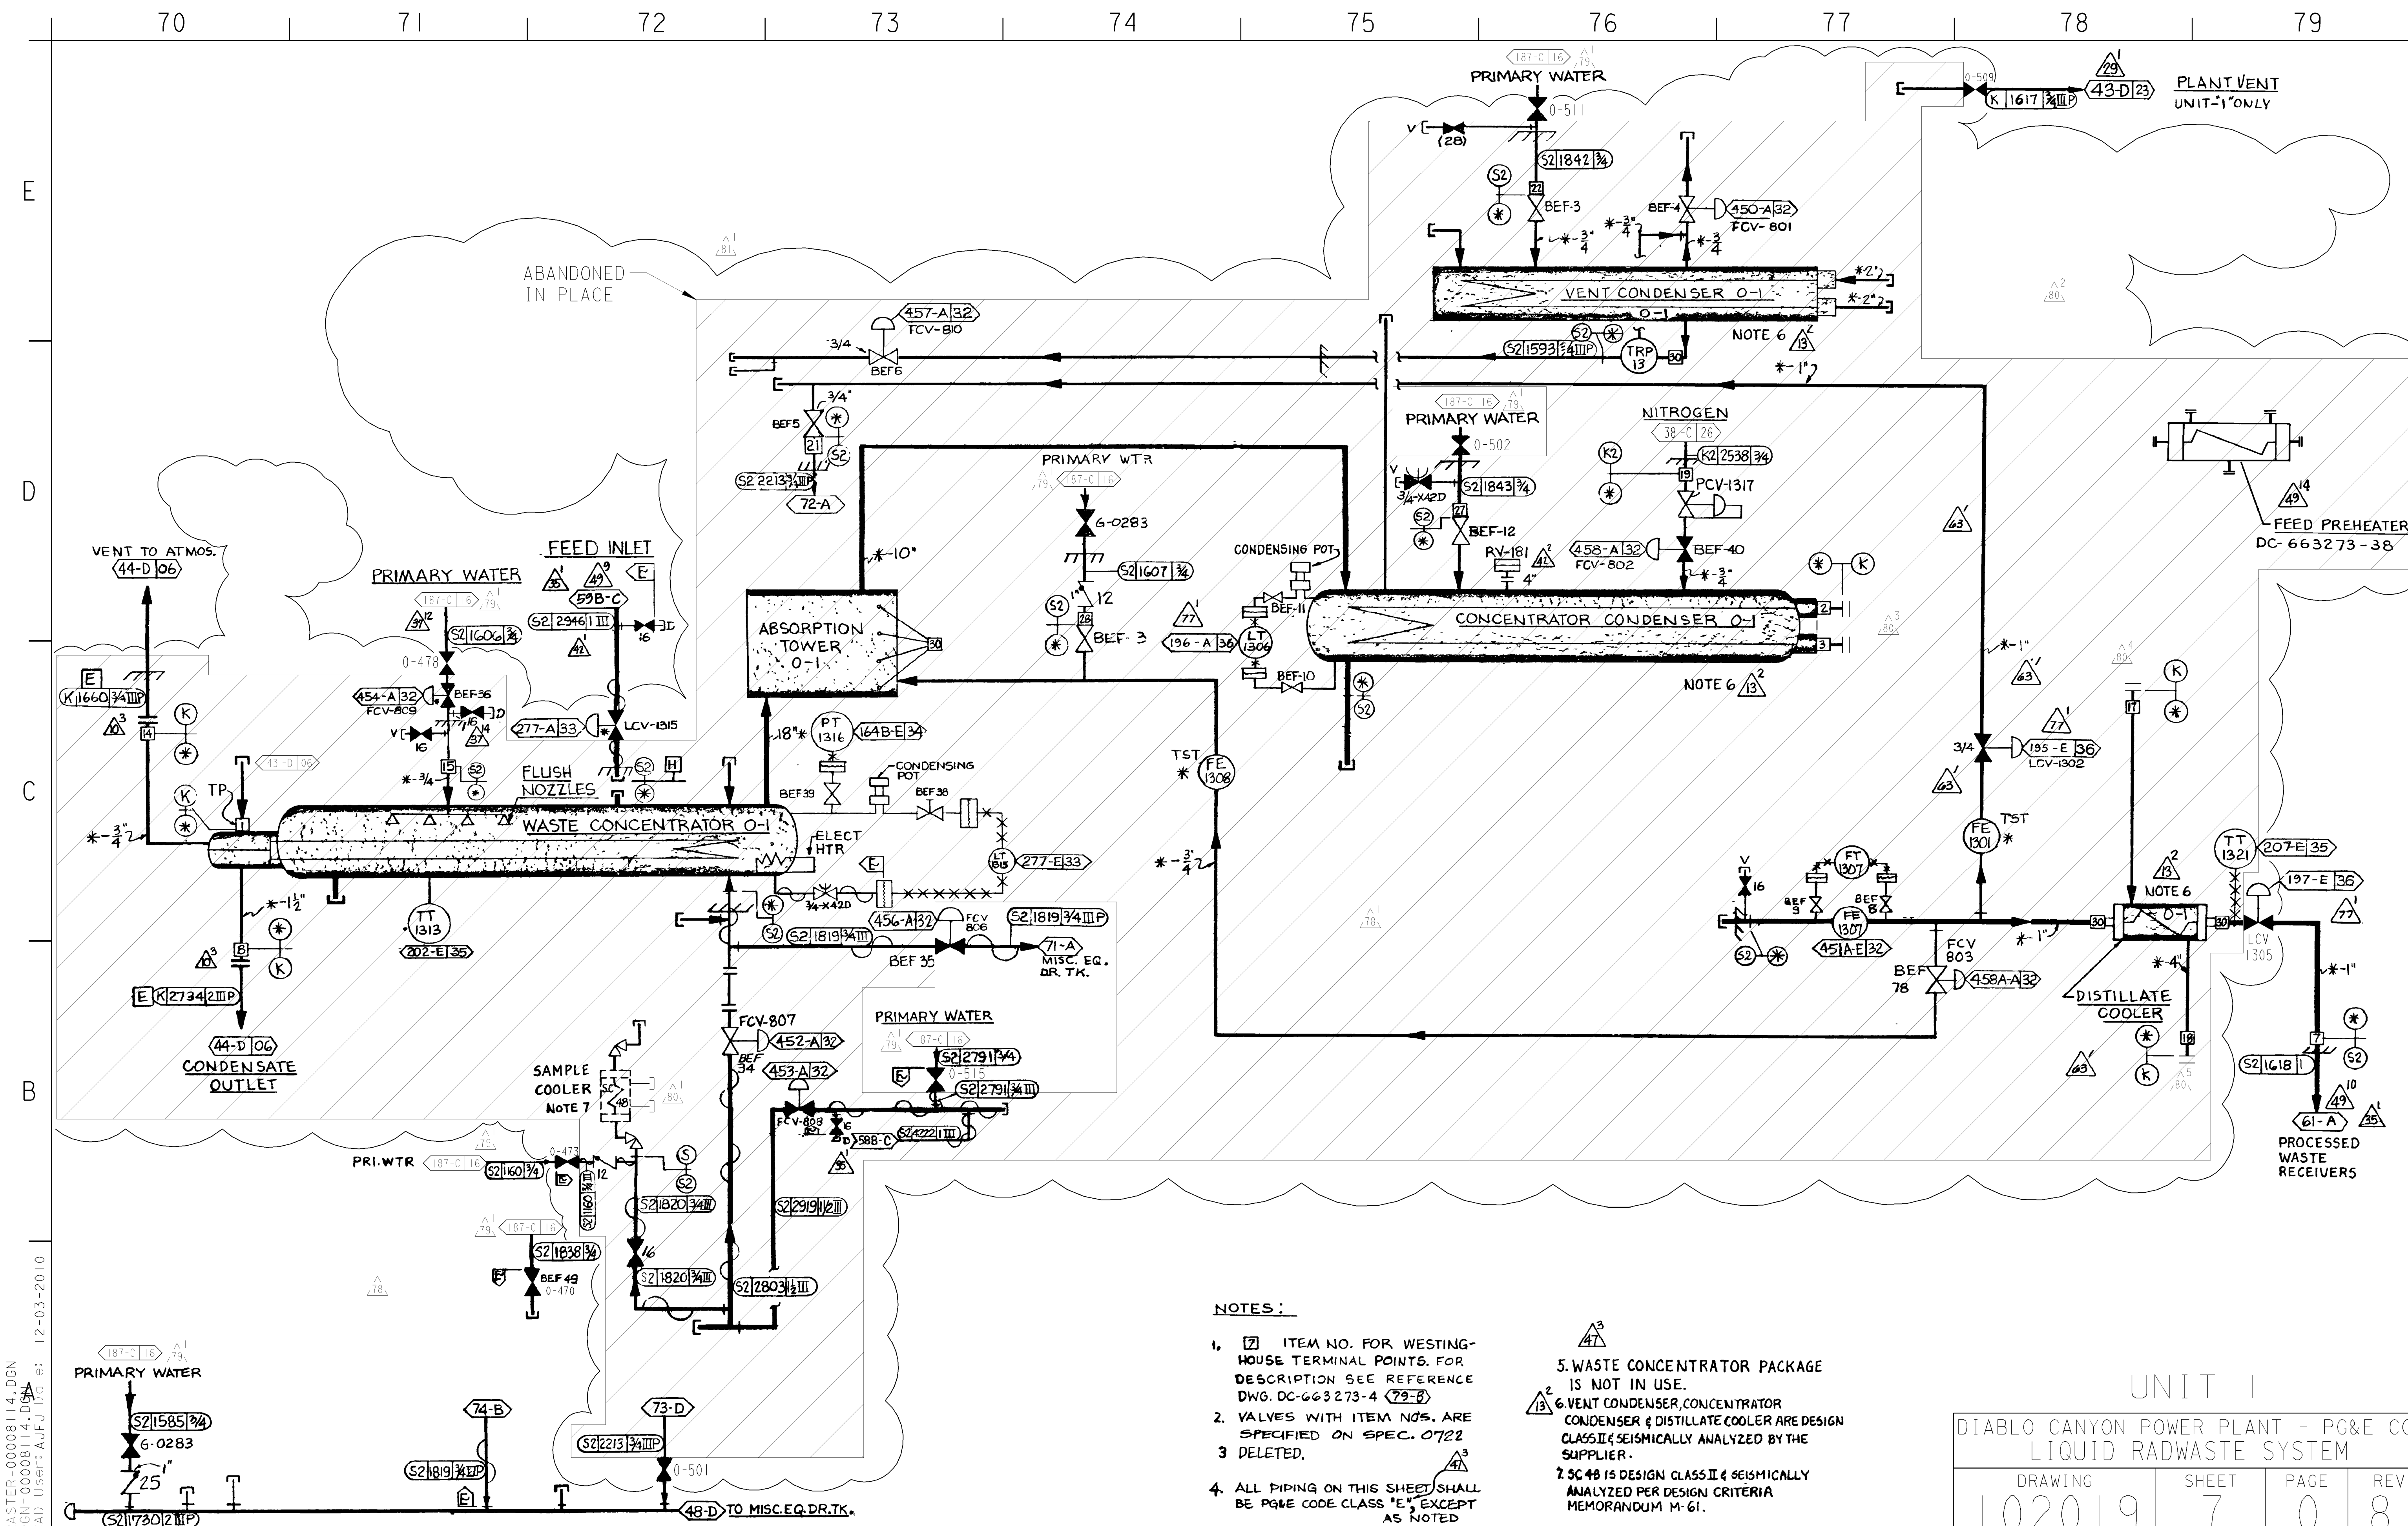

NOTES:

- 1. [2] ITEM NO. FOR WESTINGHOUSE TERMINAL POINTS. FOR DESCRIPTION SEE REFERENCE DWG. DC-663 273-4 (72-8)
- 2. VALVES WITH ITEM NOS. ARE SPECIFIED ON SPEC. 0722
- 3. DELETED.
- 4. ALL PIPING ON THIS SHEET SHALL BE PG&E CODE CLASS "E", EXCEPT AS NOTED

- 5. WASTE CONCENTRATOR PACKAGE IS NOT IN USE.
- 6. VENT CONDENSER, CONCENTRATOR CONDENSER & DISTILLATE COOLER ARE DESIGN CLASS II & SEISMICALLY ANALYZED BY THE SUPPLIER.
- 7. SC 48 IS DESIGN CLASS II & SEISMICALLY ANALYZED PER DESIGN CRITERIA MEMORANDUM M-61.

UNIT 1

DIABLO CANYON POWER PLANT - PG&E CO.
LIQUID RADWASTE SYSTEM

DRAWING	SHEET	PAGE	REV
102019	7	0	81

RASTER=00008114.DGN
DGN=00008114.DGN
CAD User: AJFJ Date: 12-03-2010

12-03-2010	AJFJ	FxC2		KERSI J. DALAL	MECHANICAL	M 16690	3/31/2012	REVISED PER DFT-7*997
DATE	DWN	RE	IV	PROFESSIONAL ENGINEER	PE DISC.	PE#	PE EXP.	