

SOUTH SITE FIREWATER LOOP

A

B

C

D

A


B

C



D

E

ALARM CHECK VALVE TRIM DIAGRAM

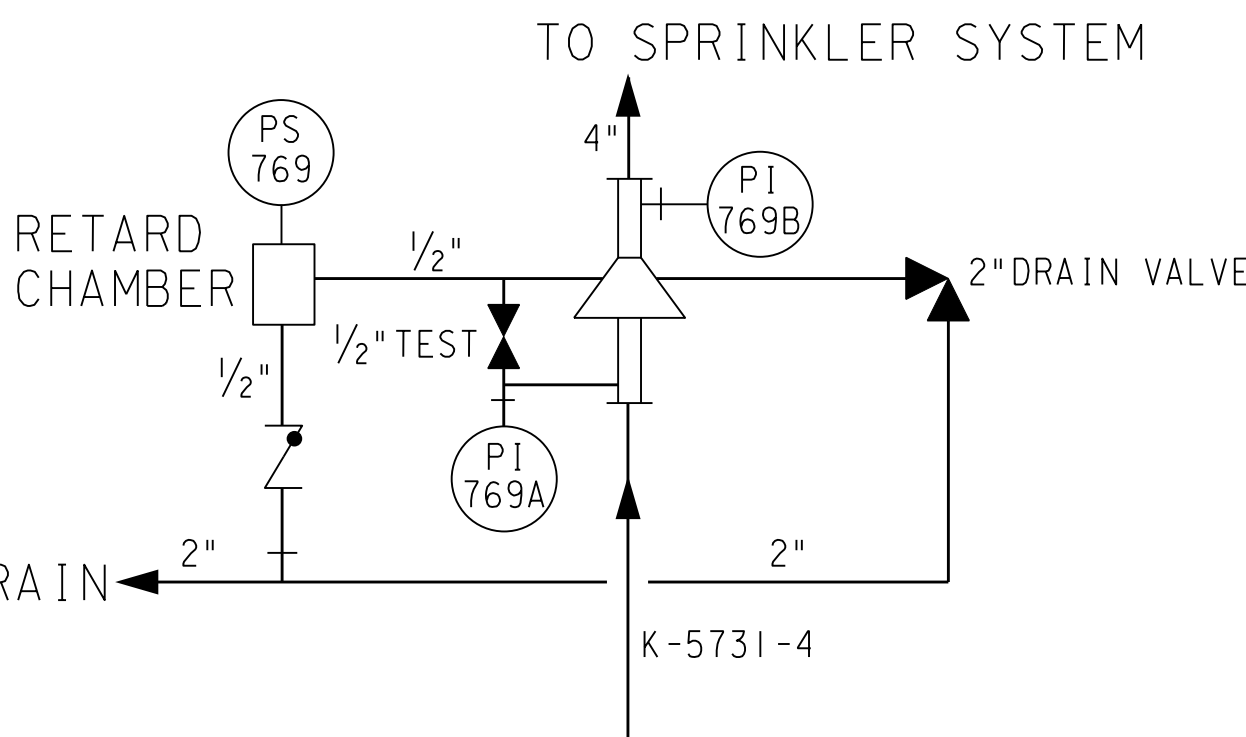

HAZARDOUS WASTE STORAGE FACILITY

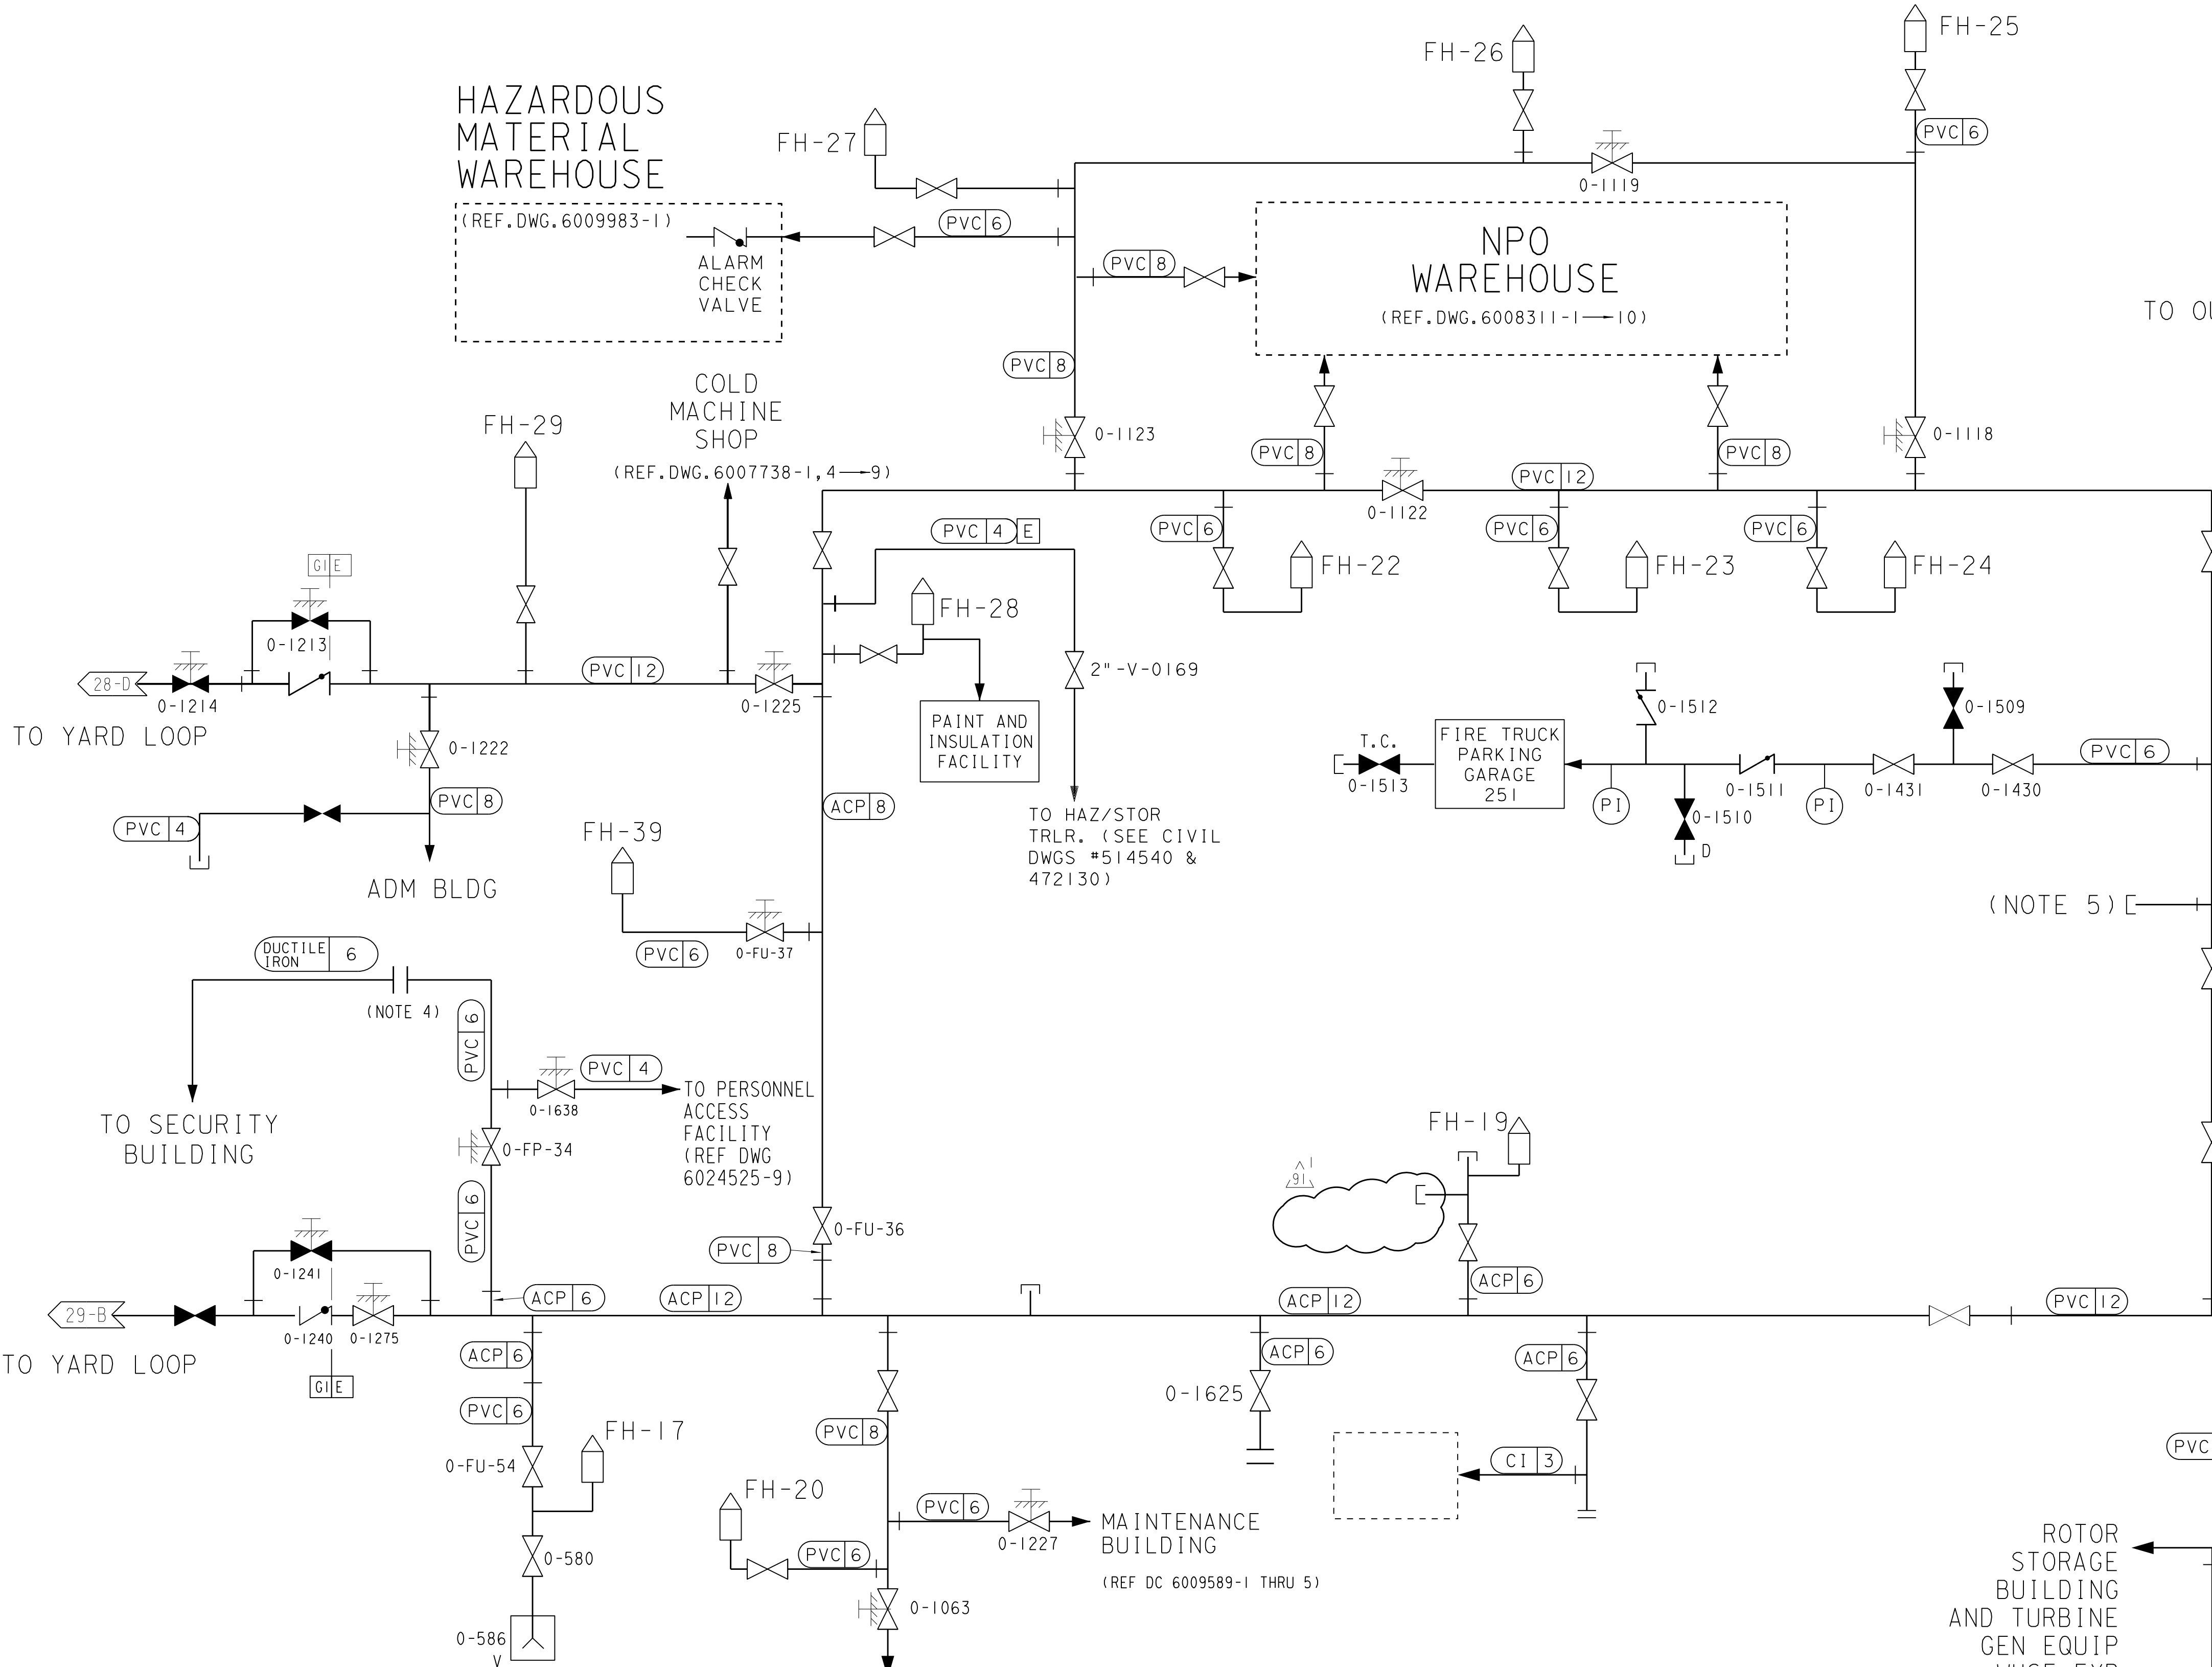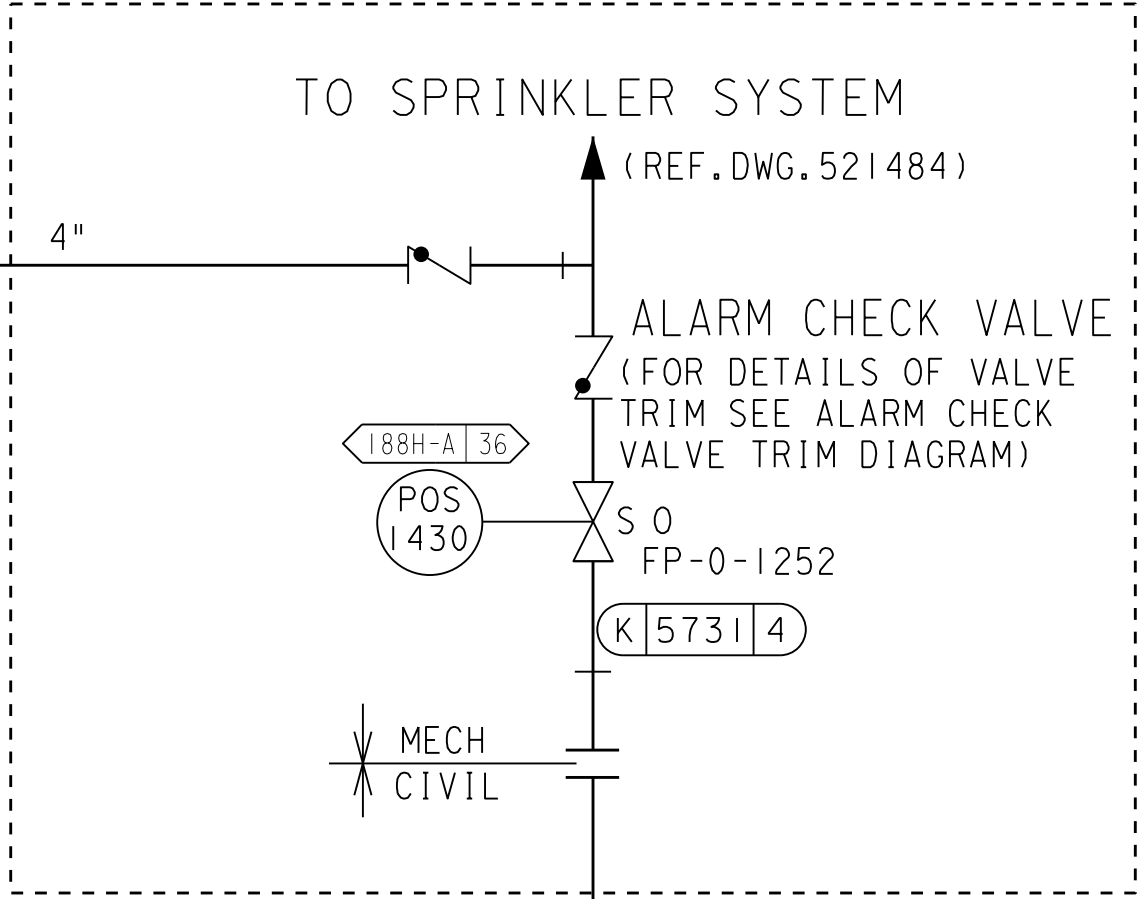

NOTE

- 1. FOR CIVIL NOTES, SEE SHEET 2
- 2. ALL PIPING ON THIS SHEET IS PG&E CODE CLASS "E", EXCEPT AS NOTED
- 3. DELETED
- 4. 6" DUCTILE IRON ELBOW WITH ONE END MECHANICAL JOINT & OTHER END FLANGED
- 5. REMOVED HYDRANT FH-37, PIPING, & ASSOCIATED VALVES EXCEPT VALVES LISTED BELOW. VALVES 0-FU-20, 0-FU-31, 0-FU-32, AND 0-FU-33 ARE DELETED BUT REMAIN BURIED AS NONFUNCTIONAL COMPONENTS. INSTALLED CAP/PLUG AT TEE OF 12" LINE.

DIABLO CANYON POWER PLANT - PG&E CO.
FIRE PROTECTION SYSTEMS

DRAWING	SHEET	PAGE	REV
102018	2A	0	91

08-14-2019	ZNS4	FXC2	N/A	NOT REQUIRED PER CF3.1D5	-	-	-	Revised Per DDN-2*1905
DATE	DWN	RE	IV	PROFESSIONAL ENGINEER	PE DISC.	PE#	PE EXP.	