


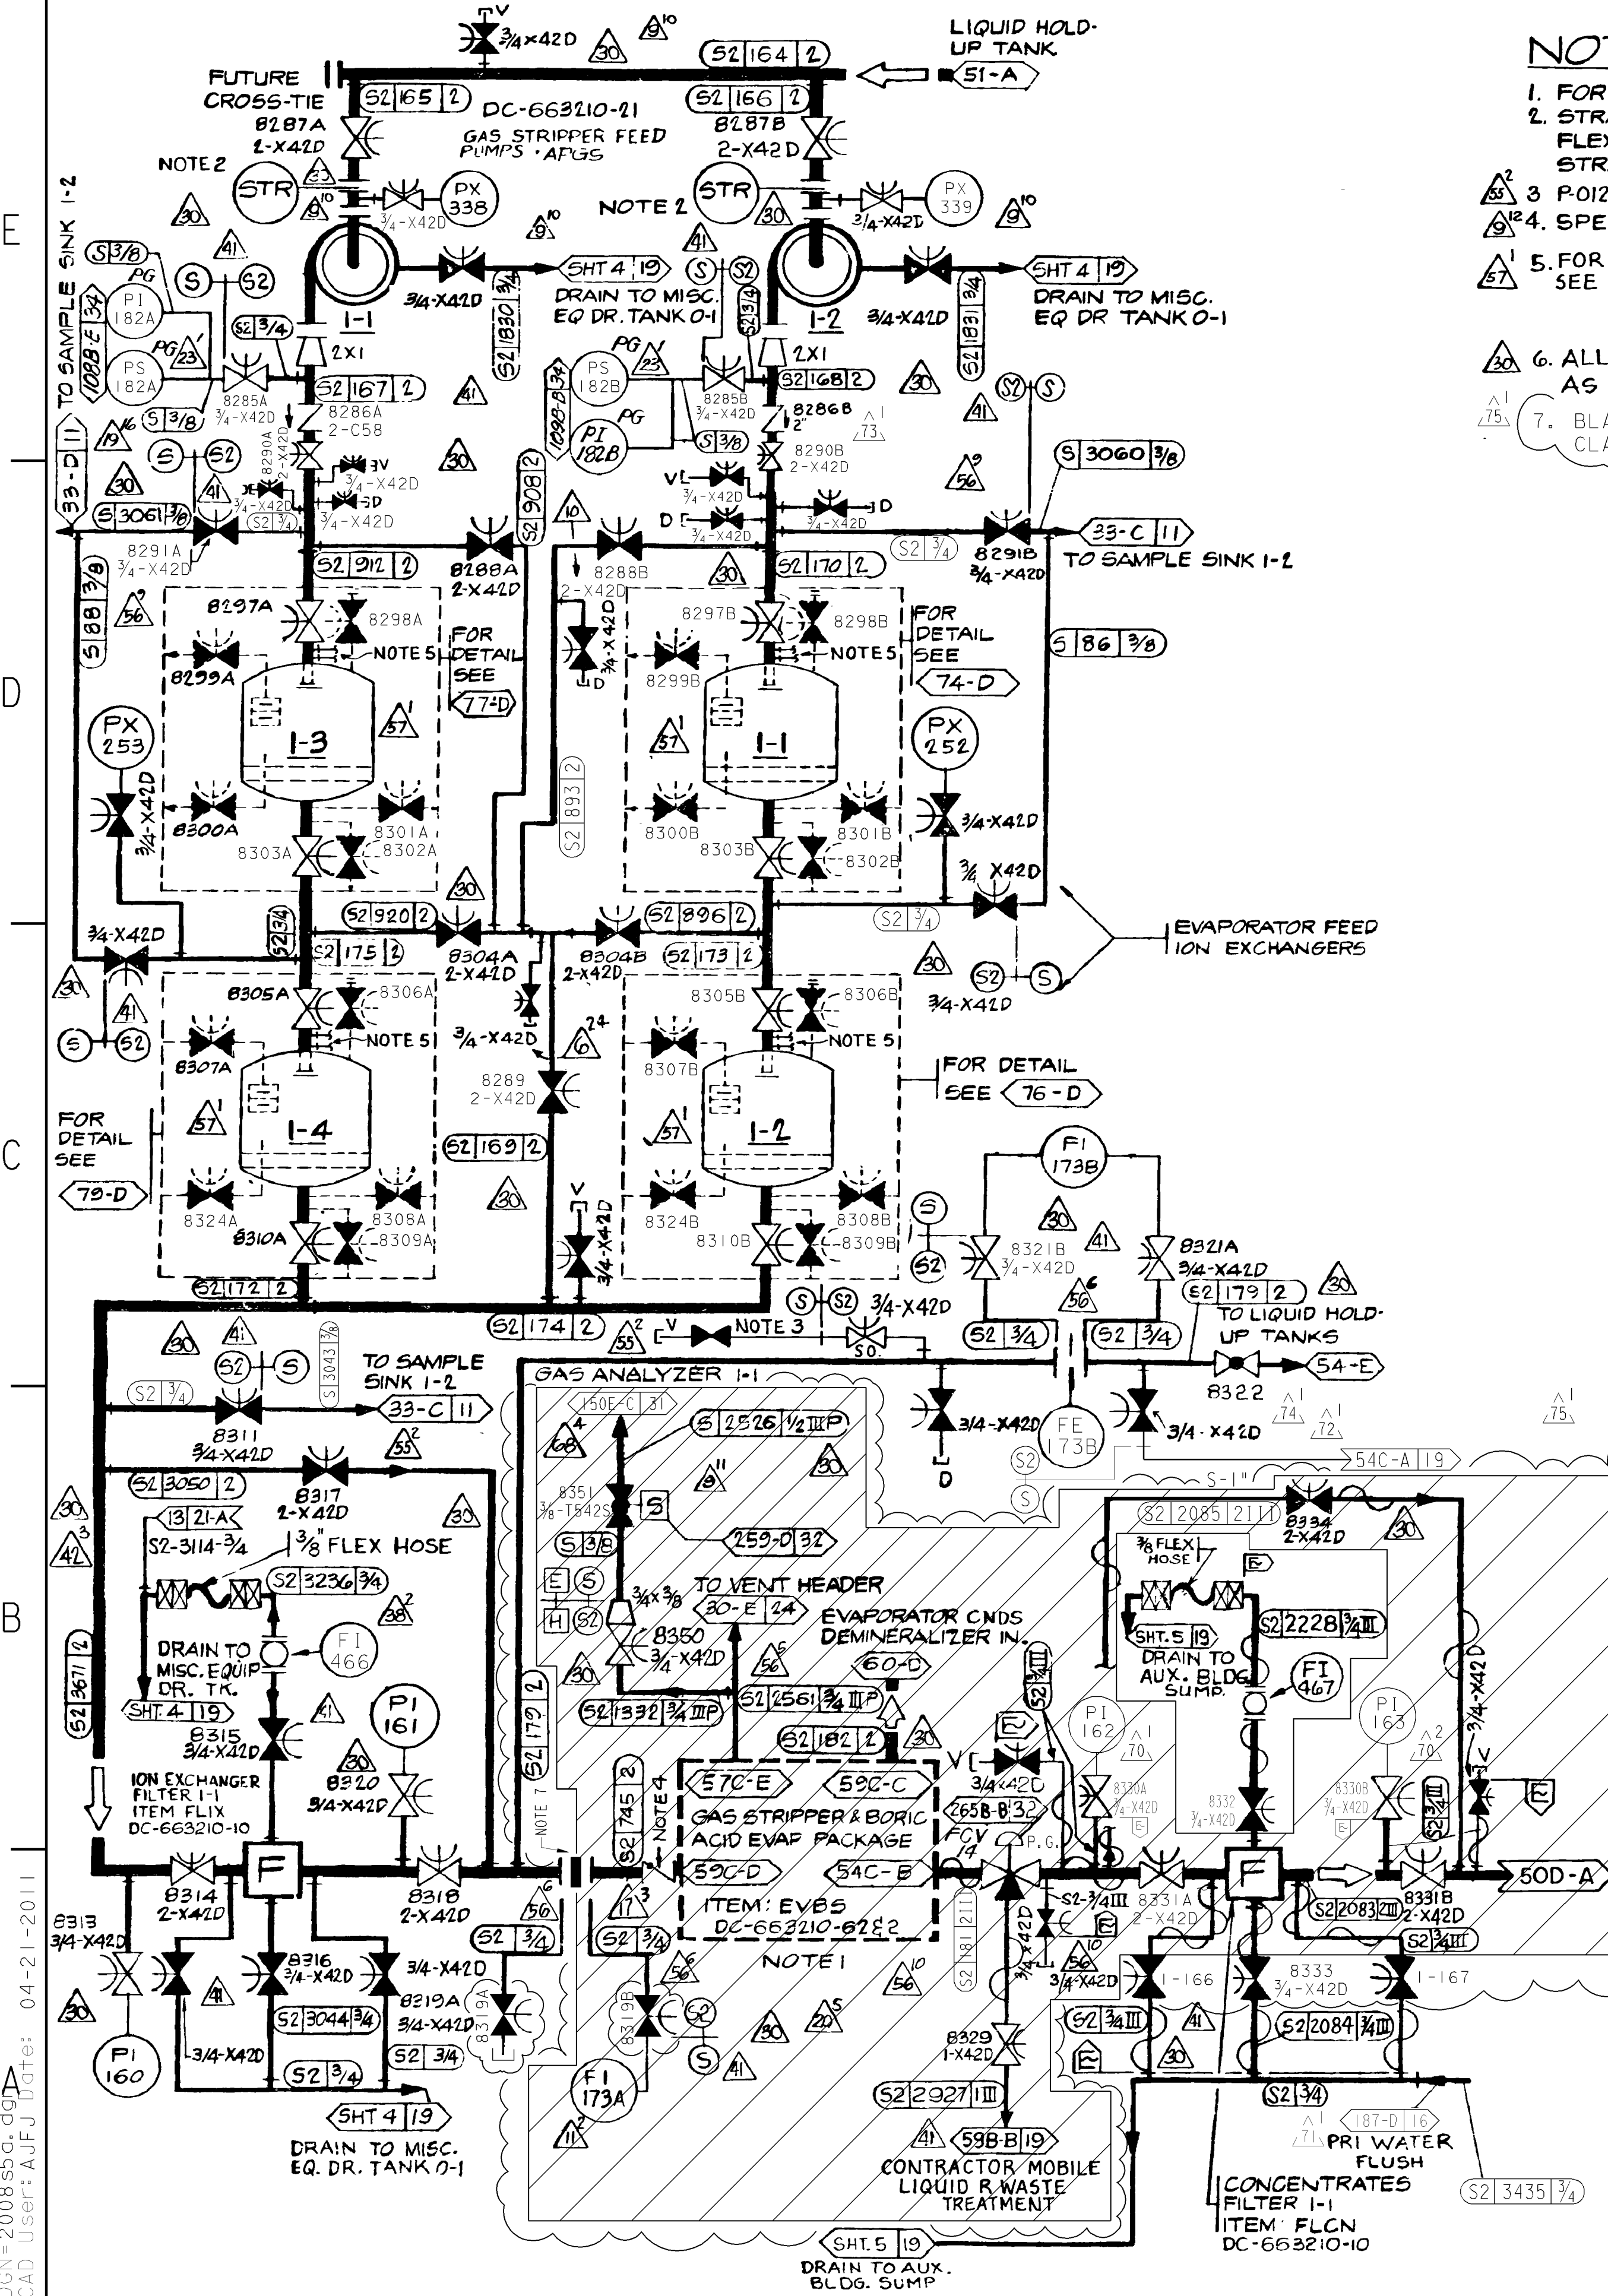

NOTES:

1. FOR DETAILS REFER TO SHEET 5C 52A-A
2. STRAINER REQUIRES FLANGE AND SUCTION PIPING FLEXIBLE ENOUGH TO FACILITATE INSTALLATION OF PANCAKE STRAINERS FOR START-UP. 51A-E 50A-E
3. P-0120 WITH PTFE SLEEVE 51A-C
4. SPEC. 0722, ITEM 21 51A-A 58A-A
5. FOR VENTS & DRAINS OFF INLET LINES SEE SHEET 7.
6. ALL PIPING ON THIS SHEET IS PG&E CODE CLASS E EXCEPT AS NOTED.
7. BLANK PLATE INSTALLED PER "S2" SPEC, CODE CLASS E.

UNIT 1

DIABLO CANYON POWER PLANT - PG&E CO.
CHEMICAL & VOLUME CONTROL SYSTEM

DRAWING 102008	SHEET 5A	PAGE 0	REV 75
-------------------	-------------	-----------	-----------