


NOTES CONT: 8. DRAIN W/ QUICK-DISCONNECT COUPLING W/ INTEGRAL CHECK VALVE FOR EMERGENCY TIE-IN TO FIRE PROTECTION SYSTEM (108018-5A). COUPLING TO BE REMOVED WHEN DRAINING IS REQUIRED.

9. DRAIN W/ QUICK-DISCONNECT COUPLING W/ INTEGRAL CHECK VALVE. DRAIN HOSE TO BE ATTACHED FOR ROUTING FLOW TO FLOOR DRAINS WHEN FPS TIE-IN (NOTE 8) IS OPERATIONAL. COUPLING TO BE REMOVED WHEN DRAINING IS REQUIRED.

10. THE INSTRUMENT AIR TO FCV-366 AND TCV-28 HAS BEEN ISOLATED. BOTH VALVES ARE FULLY OPEN. (106-B)

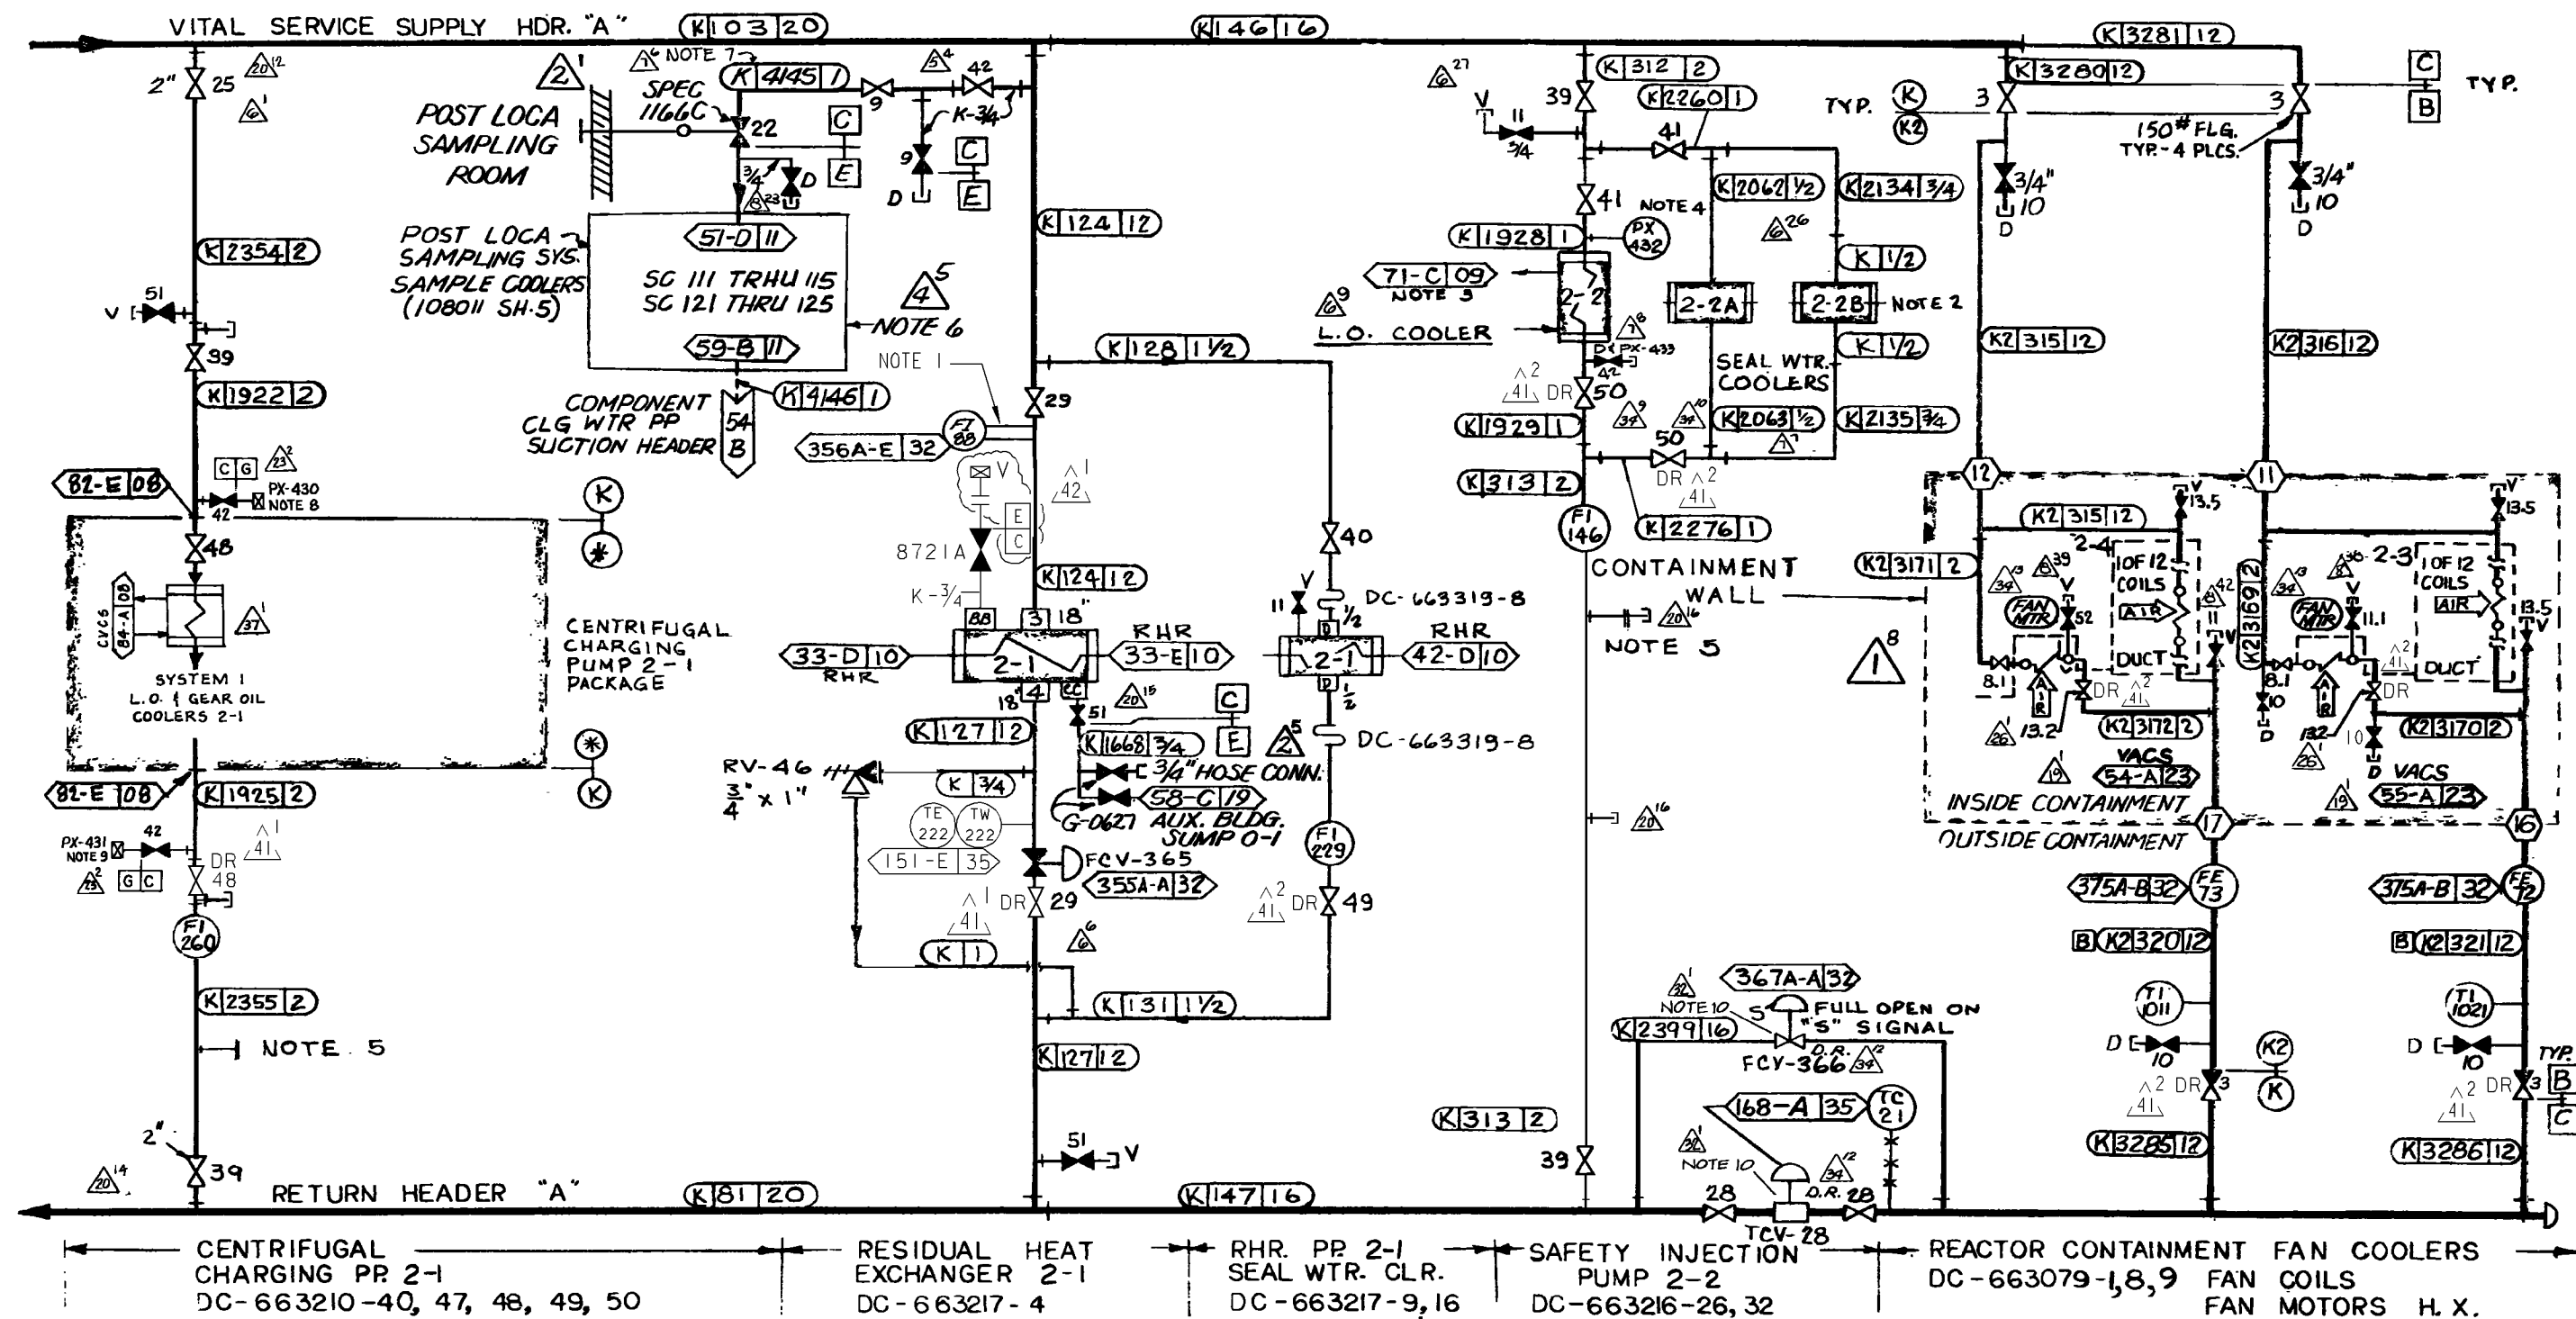

HEADER "A" COMPONENTS

NOTES:

- ELBOW TAPS FOR FLOW INDICATION (104-D)
- REFER TO SIS PP. SEAL FLUSH SYSTEM DIAGRAM, PG&E RECORD NO. DC-663216-27 (107-D)
- REFER TO SIS PP. LUBE OIL COOLER SYSTEM MFR. DWG., PG&E RECORD NO. DC-663216-26 (105-D)
- PX'S TO BE LOCATED WITHIN 1' OF H.X. (106-E)
- 2" BLIND FLANGE SEE NOTES 2 & 3 SH. 5A (100-B)
- POST-LOCA SAMPLE COOLERS ARE DESIGN CLASS II & SEISMICALLY ANALYZED PER DGM M-45 (103-D)
- CODE CLASS "E" PORTION OF LINE 4145 SHALL BE SEISMICALLY ANALYZED TO DESIGN CLASS I CRITERIA (102-E)

UNIT 2

DIABLO CANYON POWER PLANT - PG&E CO.
COMPONENT COOLING WATER SYSTEM

DRAWING	SHEET	PAGE	REV
108014	10	0	42

01-29-2008	JAR0	FxC2	KERSI J. DALAL	MECHANICAL	M 16690	3/31/2008	REVISED PER FCT-30442
DATE	DWN	RE	IV	PROFESSIONAL ENGINEER	PE DISC.	PE#	PE EXP.