


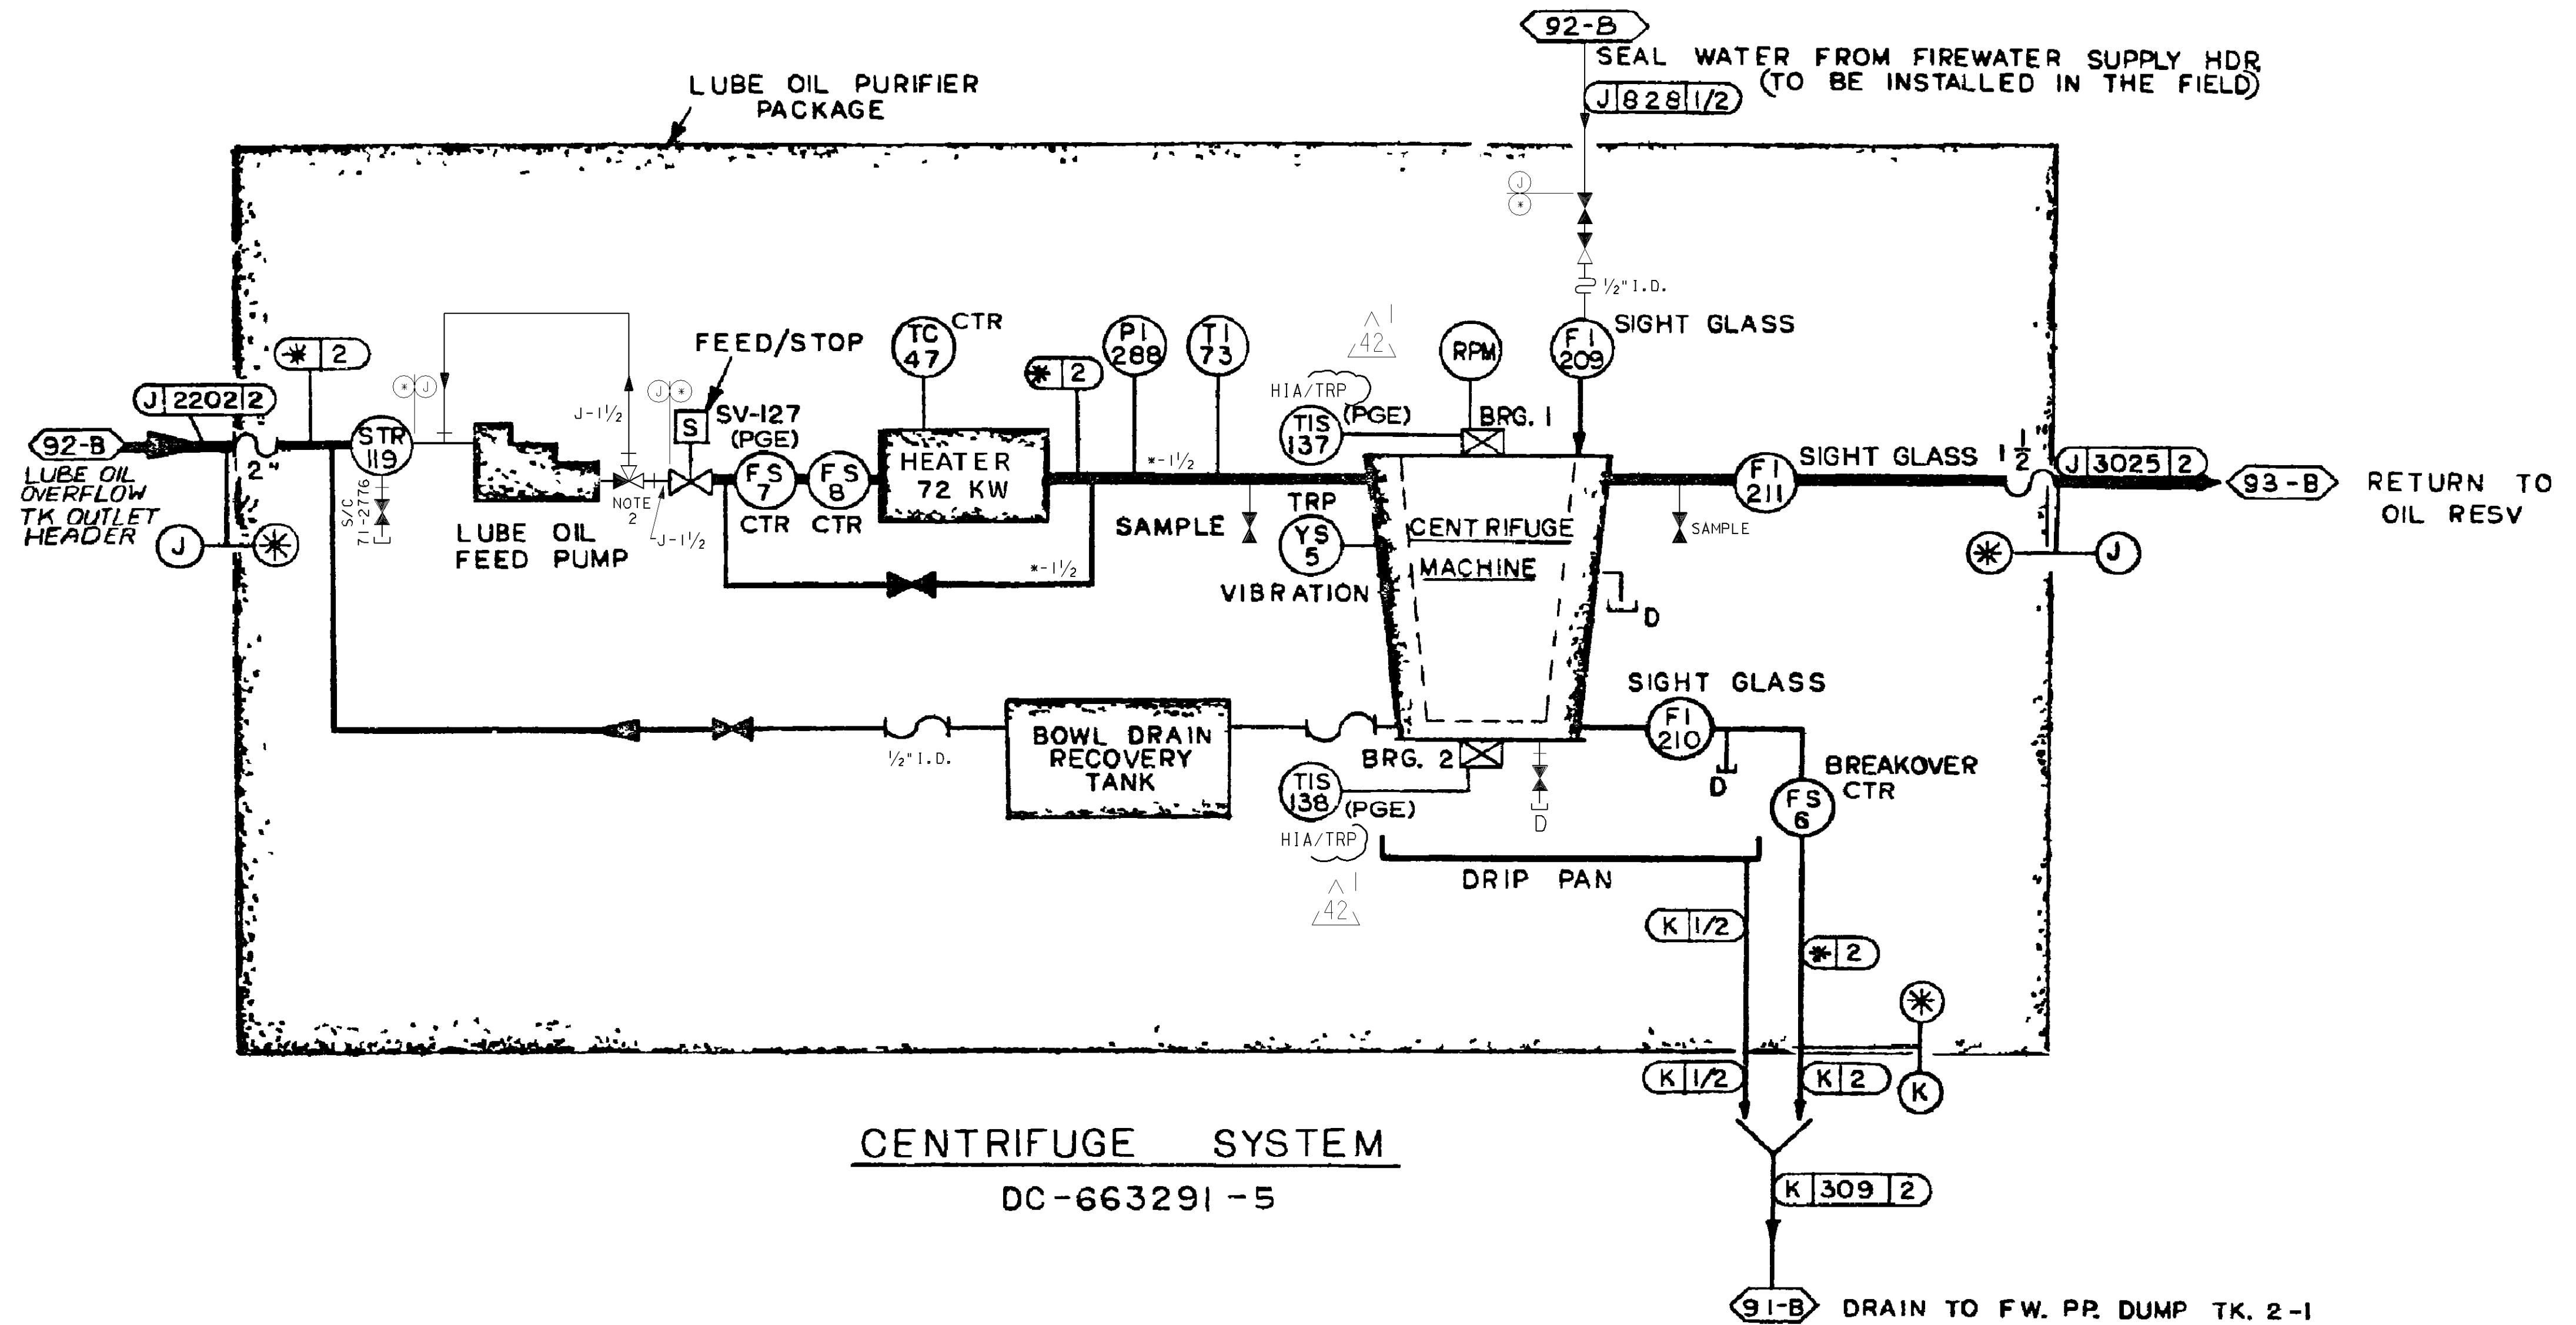

NOTES:

1. ALL INSTRUMENTS ARE SUPPLIED BY THE EQUIPMENT VENDOR EXCEPT AS NOTED.
2. JAMESBURY 3-WAY MANUAL FLOW CONTROL VALVE, MODEL AM150FD2236MT. (102-B)

UNIT 2

DIABLO CANYON POWER PLANT - PG&E CO.
LUBE OIL DISTRIBUTION AND PURIFICATION SYSTEMS

DRAWING	SHEET	PAGE	REV
108020	10	0	42

INPGIC
1 Size

09-10-2015	ZNS4	FxC2	RxG2	NOT REQUIRED PER CF3.ID5	-	-	-	REVISED PER DFT-7*3205
DATE	DWN	RE	IV	PROFESSIONAL ENGINEER	PE DISC.	PE#	PE EXP.	

RASTER=108020s10p0.dgn
DGN=108020s10p0.dgn
CAD User: ZNS4 Date: 09-10-2015