RELAY	LOCATION	DESCRIPTION
SRX/FAN	3-5-22	(D) LOSS OF FAN OR FAN POWER

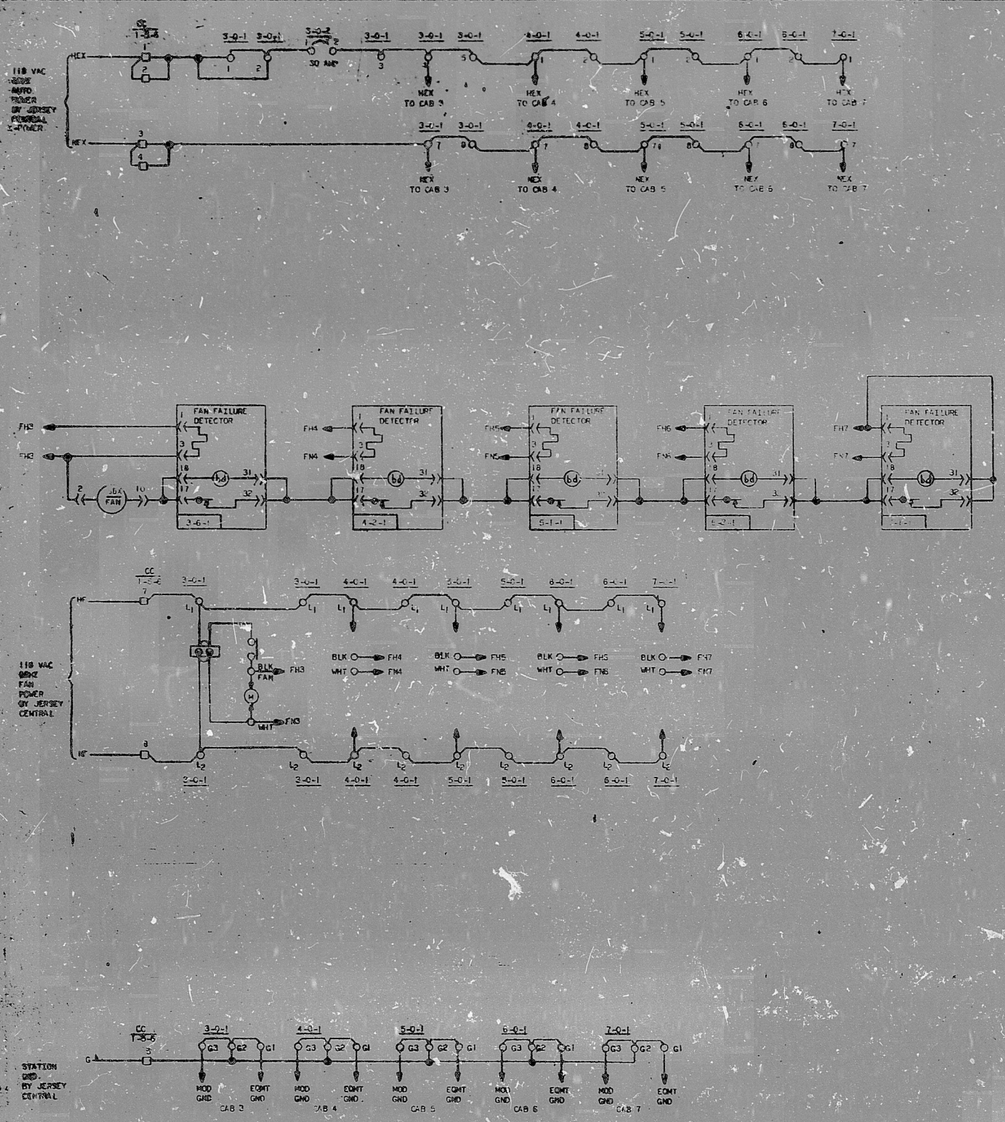

AS-BUILT DRAWING

FILE COPY

FOR NOTES AND REFERENCES SEE DWG. D8038462

NON-NUCLEAR INSTRUMENTATION
DETAILED SCHEMATIC
POWER DISTRIBUTION-MET-ED

CUSTOMER : JERSEY CENTRAL POWER AND LIGHT
PLANT : THREE MILE ISLAND NUCLEAR STATION UNIT #2
CONTRACTING ENGR. BURNS AND ROE
B.M.CO. JOB NO: 1595L

22-15 251 02

THIS DRAWING IS THE PROPERTY OF BAILEY METER COMPANY. NEITHER THE DRAWING, NOR REPRODUCTIONS OF IT, NOR INFORMATION OBTAINED FROM IT IS TO BE GIVEN TO OTHERS. NO USE IS TO BE MADE OF IT WHICH IS OR MAY BE INJURIOUS TO BAILEY METER COMPANY.

REV	DATE	CHANGE	APPD

BAILEY METER COMPANY
WICKLIFFE, OHIO
7965226246

D8038515 A

7905220246

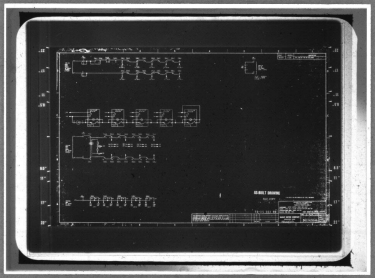

MMM 5001 FILMSORT® Brand Aperture & Camera Cards and DUPLICARD® Brand Copy Cards — Product of 3M Company, St. Paul, Minn.