C-41

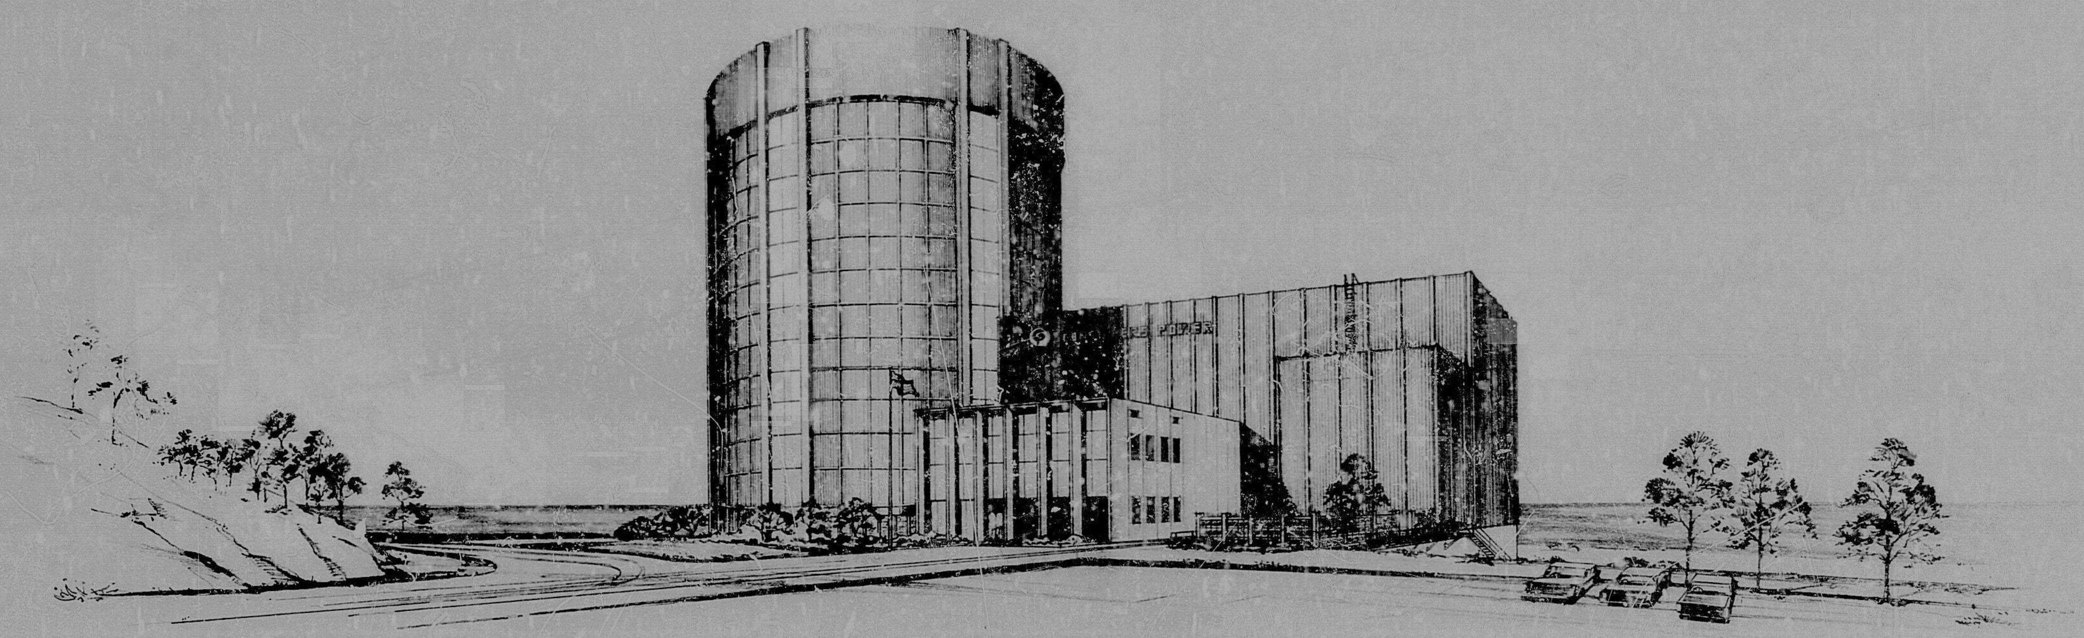

No.	DATE	REVISIONS	BY	CHK	DSTG. SUPV.		PROJ. ENGR.	CHIEF ENG'R
3	1-16-75	MARKED SH. 2	MWS	ERL	T.S. APPR.:			
2	10-28-74	ISSUED FOR AS-BUILT 5935-6	MW	AC	ACC			
1	6-30-71	ADDED NEW RADWASTE FACILITY	HW	AC	ACC			
0	3-5-68	ISSUED FOR CONSTRUCTION	I.R.	AC	ACC			

SCALE NONE | DESIGNED A. CHEVALIER | DRAWN M.W. WONG

BECHTEL COMPANY

PALISADES PLANT
CONSUMERS POWER COMPANY

ARCHITECTURAL
PLANT PERSPECTIVE

JOB No.	DRAWING No.	REV.
5935	C-41 SH. 2	3

34 x 44

950GC 41 3 2 PLANT PERSPECTIVE 751

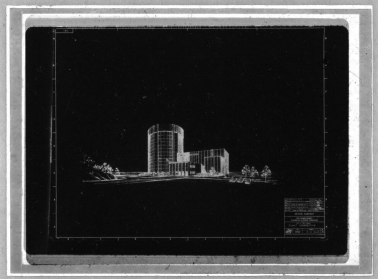

8101130354