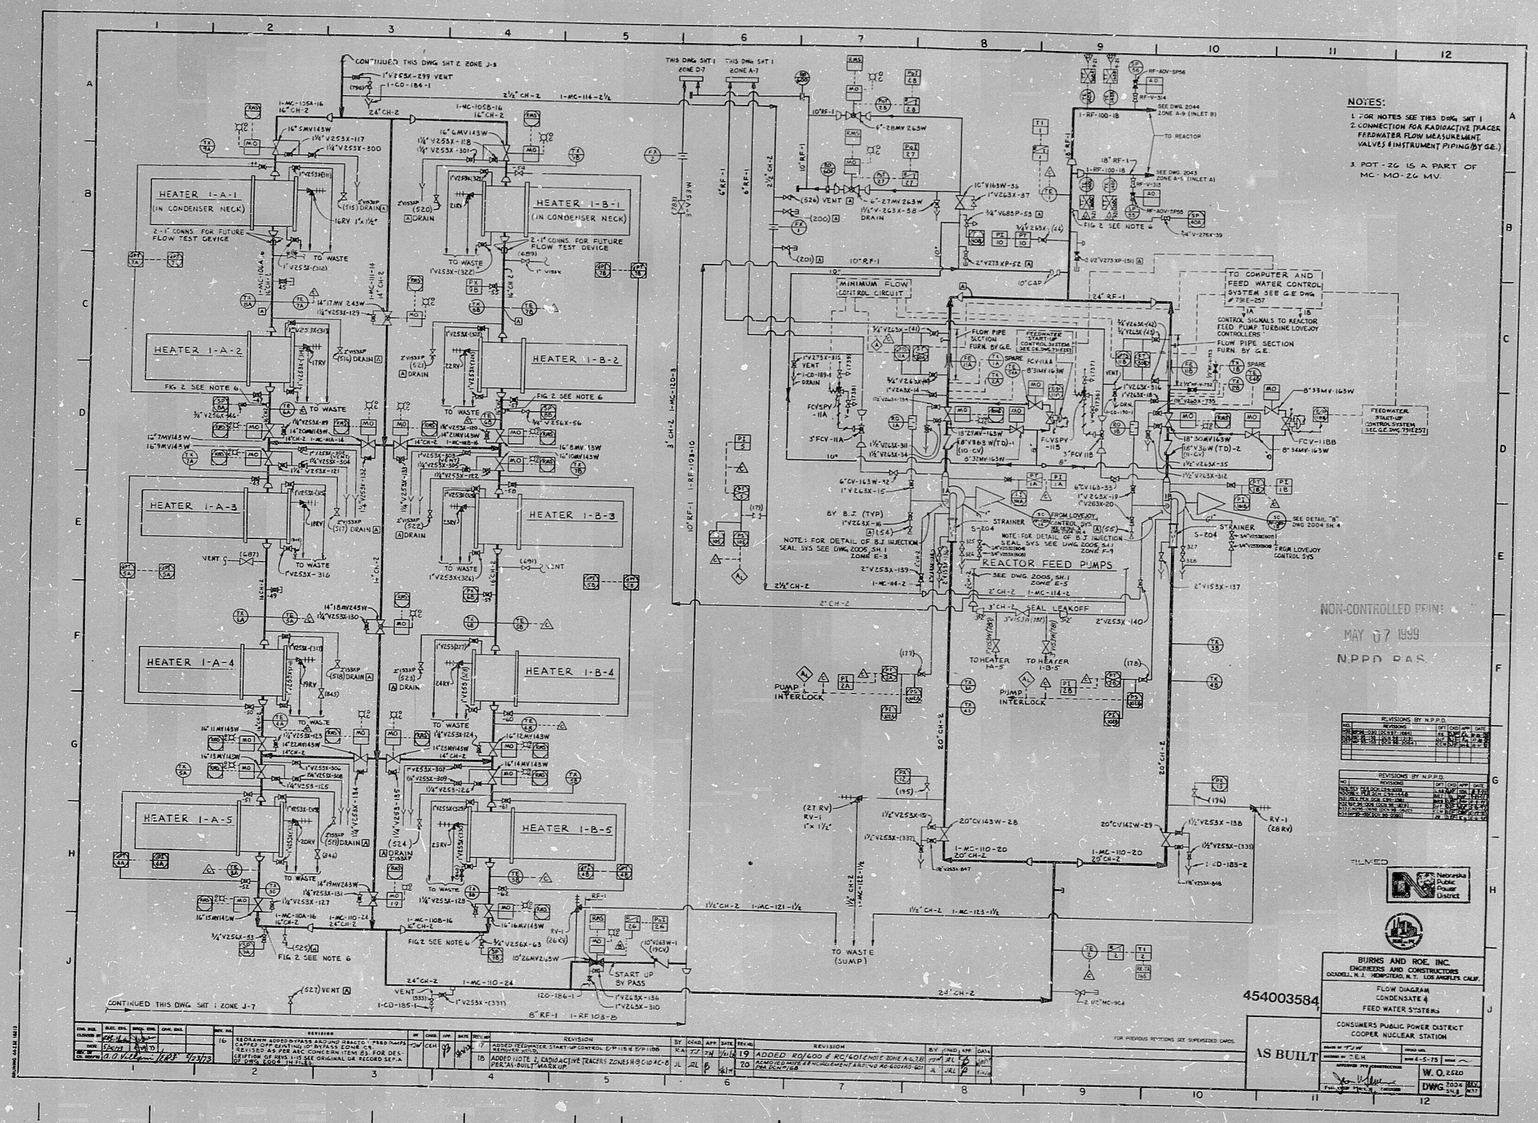
HEATER 1-A-1 (IN CONDENSER NECK)
HEATER 1-A-2
HEATER 1-A-3
HEATER 1-A-4
HEATER 1-A-5
HEATER 1-B-1 (IN CONDENSER NECK)
HEATER 1-B-2
HEATER 1-B-3
HEATER 1-B-4
HEATER 1-B-5
MINIMUM FLOW CONTROL CIRCUIT
REACTOR FEED PUMPS
TO COMPUTER AND FEED WATER CONTROL SYSTEM SEE G.E. DWG #THE-257
FLOW PIPE SECTION FURN. BY G.E.
FEEDWATER START UP CONTROL SYSTEM SEE G.E. DWG. THE-257
TO WASTE (SUMP)
START UP BY PASS
NOTES:
1. FOR NOTES SEE TIB3 DWG SHT 1
2. CONNECTION FOR RADIOACTIVE TRACER, FEEDWATER FLOW MEASUREMENT, VALVES & INSTRUMENT PIPING (BY G.E.)
3. POT-26 IS A PART OF MC-MO-26 MV.
NON-CONTROLLED PRINT
MAY 07 1999
NPPD RAS
454003584
AS BUILT
BURNS AND ROE, INC.
ENGINEERS AND CONSTRUCTORS
FLOW DIAGRAM
CONDENSATE & FEED WATER SYSTEMS
CONSUMERS PUBLIC POWER DISTRICT
COOPER NUCLEAR STATION
W.O. 2220
DWG 2003
DEC. 23, 1998 NPPD
APERTURE CARD

9907160056

PDR RIDS

9907160056

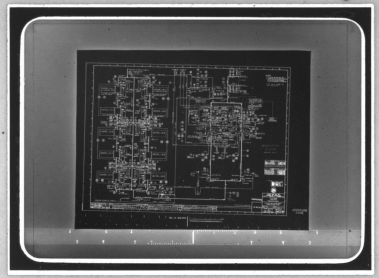

MMM 5824