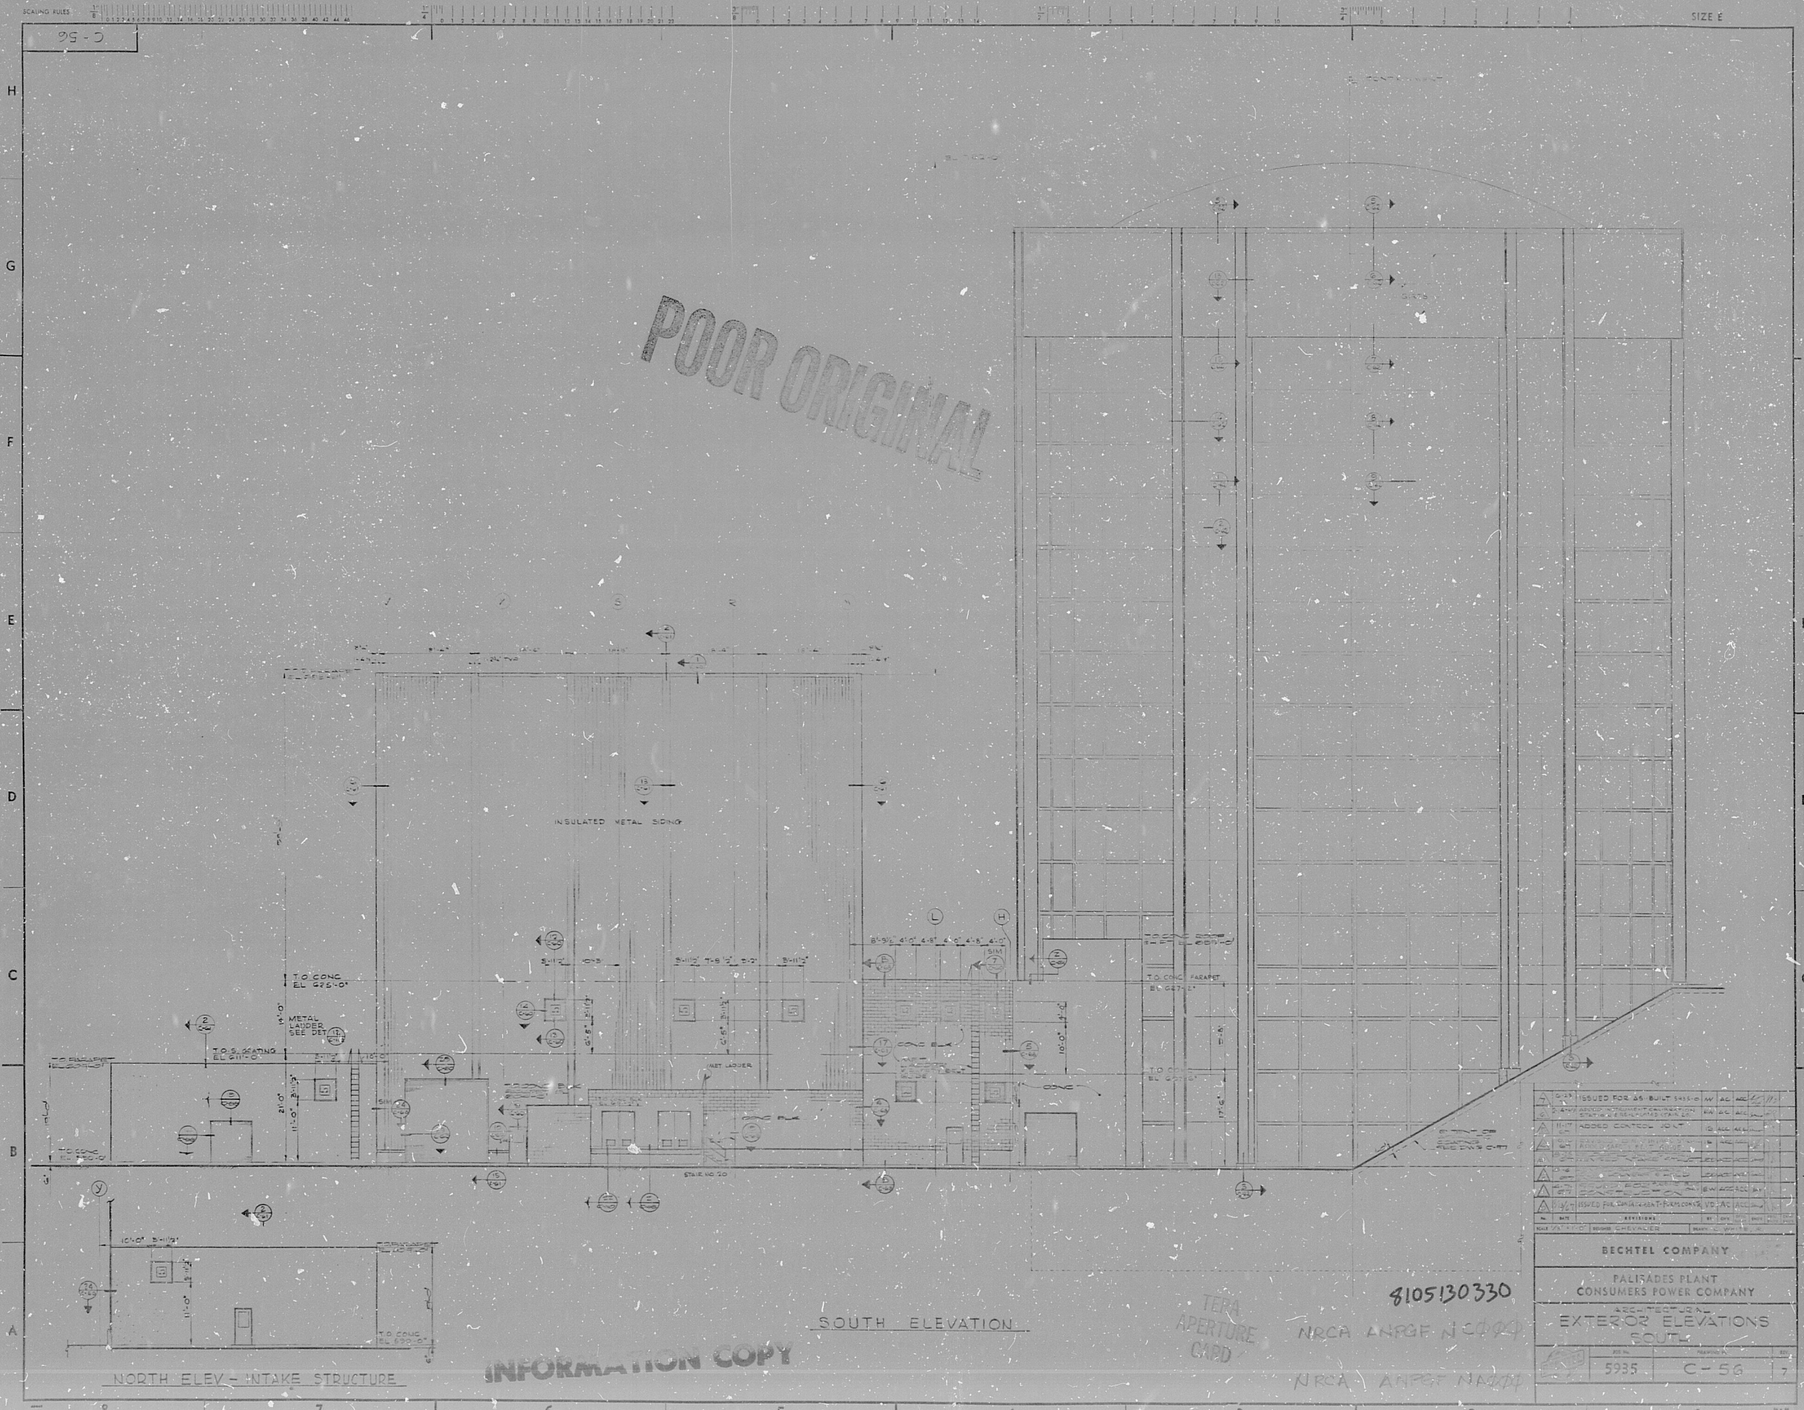
SCALING RULES
SIZE E
C-56
INSULATED METAL SIDING
T.O. CONC. EL. 675'-0"
T.O. S. SEATING EL. 671'-0"
T.O. CONC. EL. 671'-0"
T.O. CONC. PARAPET EL. 671'-0"
T.O. CONC. EL. 655'-0"
INLET LOUVER
STAIR NO. 50
SOUTH ELEVATION
NORTH ELEV - INTAKE STRUCTURE
ISSUED FOR AS-BUILT
REVISIONS
BECHTEL COMPANY
PALISADES PLANT
CONSUMERS POWER COMPANY
EXTERIOR ELEVATIONS
SOUTH
5935
C-56
8105130330
TERA APERTURE CARD
NRCA AMPGF NA000
INFORMATION COPY
POOR ORIGINAL

8105130330

DOCKET NUMBER	ACCESSION NUMBER	DRAWING NUMBER	SHEET	REV.

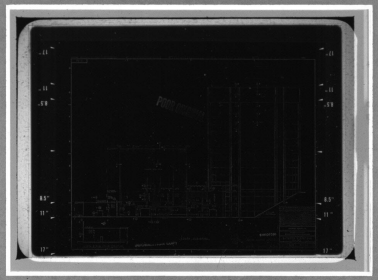

MAM 10390 FILMSORT® Board Aperture & Camera Cards and DUBLICARD® Board Copy Cards — Product of 3M, St. Paul, Minn.