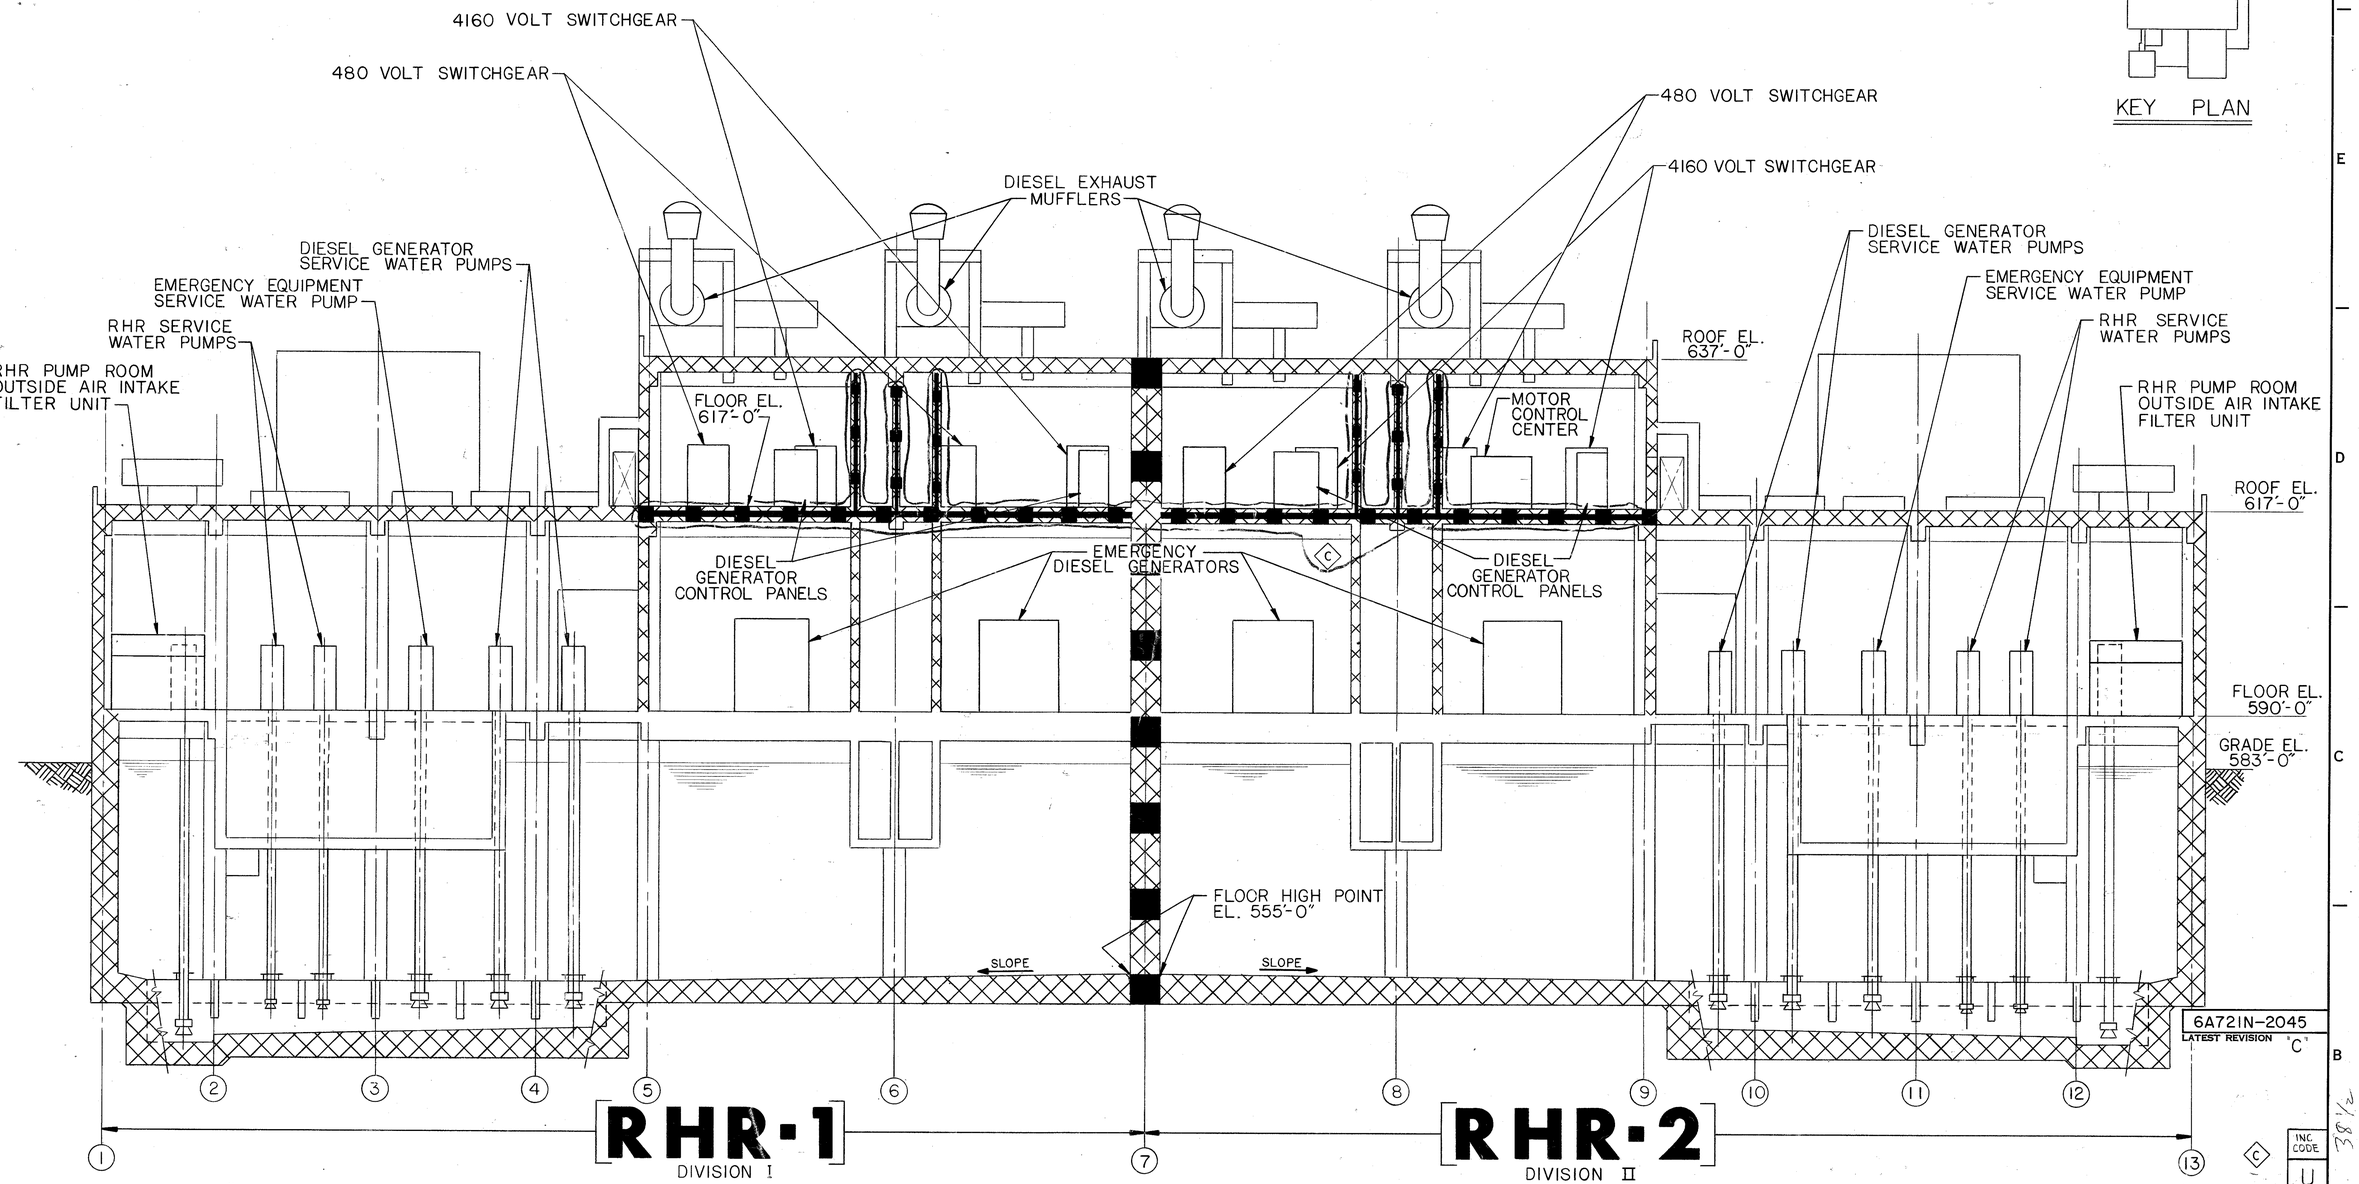

SECTION C-C

KEY PLAN

6A72IN-2045
LATEST REVISION "C"

INC. CODE U

NON-NUCLEAR SAFETY RELATED

A Portion of This Document is Affected by the Following

DTC	Change Document	DTC	Change Document

EDP Posting Entries Require the Addition of the Arms Status Code: Either "AFC" or "ASB"

DE 963-1399 5-86 X

	PROJ. ENG.	PROJ. DIR.	STR. ENG.	OTHER APPROVALS	DATE
A	WHS	RA BAKER FOR WHS	RC ANDERSON	RC ANDERSON for KWM	1-12-78

REMOVED RATED FIRE BARRIERS BETWEEN DIESEL GENERATORS ON EL 590'-0" AT (DC-3,4,5) PER CLIENT COMMENTS

OFW BBPIAO

MADE BY NIA 12-1-83 | CH'K BY TJM 12/9/83 | ARCH-CIVIL RC WHEELER, S HERMIZ | MECH. | ELECT. | DIV. DIRECTOR LG JOHNSON /RCW

	PROJ. ENG.	PROJ. DIR.	STR. ENG.
B	Kd Sood for S Hermiz		

TRACING RECEIVED FROM GILBERT ASSOCIATES 11-3-86 AND WILL BE MAINTAINED BY EDISON.

"DRAWING ISSUED FOR RECORD ONLY"

OFW BBPIAO

MADE BY L ANDERSON 11-8-86 | CH'K BY RC WHEELER 11/4/86 | ARCH-CIVIL K.C. ZOMAYA | MECH. | ELECT. L.E. Wanson /RCW | DIV. DIRECTOR /RCW

	PROJ. ENG.	PROJ. DIR.
C	~~PROJ. ENG.~~	~~PROJ. DIR.~~

REVISED PER ABN 10884-1 REV 0 ADDED INC. CODE

MADE BY C BYRD 1-3-90 | CH'K BY M. Khan 1-11-90 | ARCH-CIVIL Mahler 3-15-91 | MECH. | ELECT. | DIV. DIRECTOR

OFW

	PROJ. ENG.	PROJ. DIR.
D		
E		
F		
G		
H		
I		

OFW

MADE BY | DATE | ARCH-CIVIL | ELECT.
CH'K BY | DATE | MECH. | DIV. DIRECTOR

DIVISION	SUPERVISOR	DATE
ARCH-CIVIL	JV BELKO	11-28-77
	A ALCHALABI	1-4-78
	FB YOUNG	12-7-77
CONTROL & ELECT.	WF COLBERT/WMS	1-17-78
	LG PRON	1-3-78
MECH.		
STATIONS ENG.		

	DRAWN BY	DATE
	GILBERT ASSOC	6-29-77
	CHECKED BY	DATE
	GILBERT ASSOC	6-29-77
	PROJECT ENGINEER	DATE
	WF COLBERT/WMS	1-17-78
	PROJECT DIRECTOR	DATE
	DIVISION DIRECTOR	DATE
	DAVID SPIERS	1-9-78

REF. DWGS. | REF. BMS.

THE DETROIT EDISON CO. — ENGINEERING DEPARTMENTS

GILBERT ASSOCIATES, INC. ENGINEERS AND CONSULTANTS READING, PA

DRAFTING: MADE CoK (12/27/77-2/17) | CHECKED JWM
SD LDR: J McMullen 2-29-77
ENGINEERING INTERFACES: 1. | 2. | 3. | 4.
ENGINEER APPROVAL | DEPT. | DATE: 8/21/79
SCALE 1/8"=1'-0" | P.O. 044761-000

04	4761	D-023-017	0

DRAWING NUMBER | REV

TITLE: FIRE PROTECTION EVALUATION
RESIDUAL HEAT REMOVAL COMPLEX
SECTION C-C

LOCATION: ENRICO FERMI ATOMIC POWER PLANT UNIT 2

APERT. CD TITLE: DOCUMENT CONTROL NO. X80-03-0-000-DA-013, X00-03-
FIRE PROT EVAL RHR SECTION C-C

DRAWING NUMBER: 6A72IN-2045 | REV: C | NUC OPS FILE #1901 | RECIPT
DTC DDACS | DATE TO VS Feb 24, 1980

DE FORM DS 71 REV. 5-71 PTG. 3-77A

38 1/2