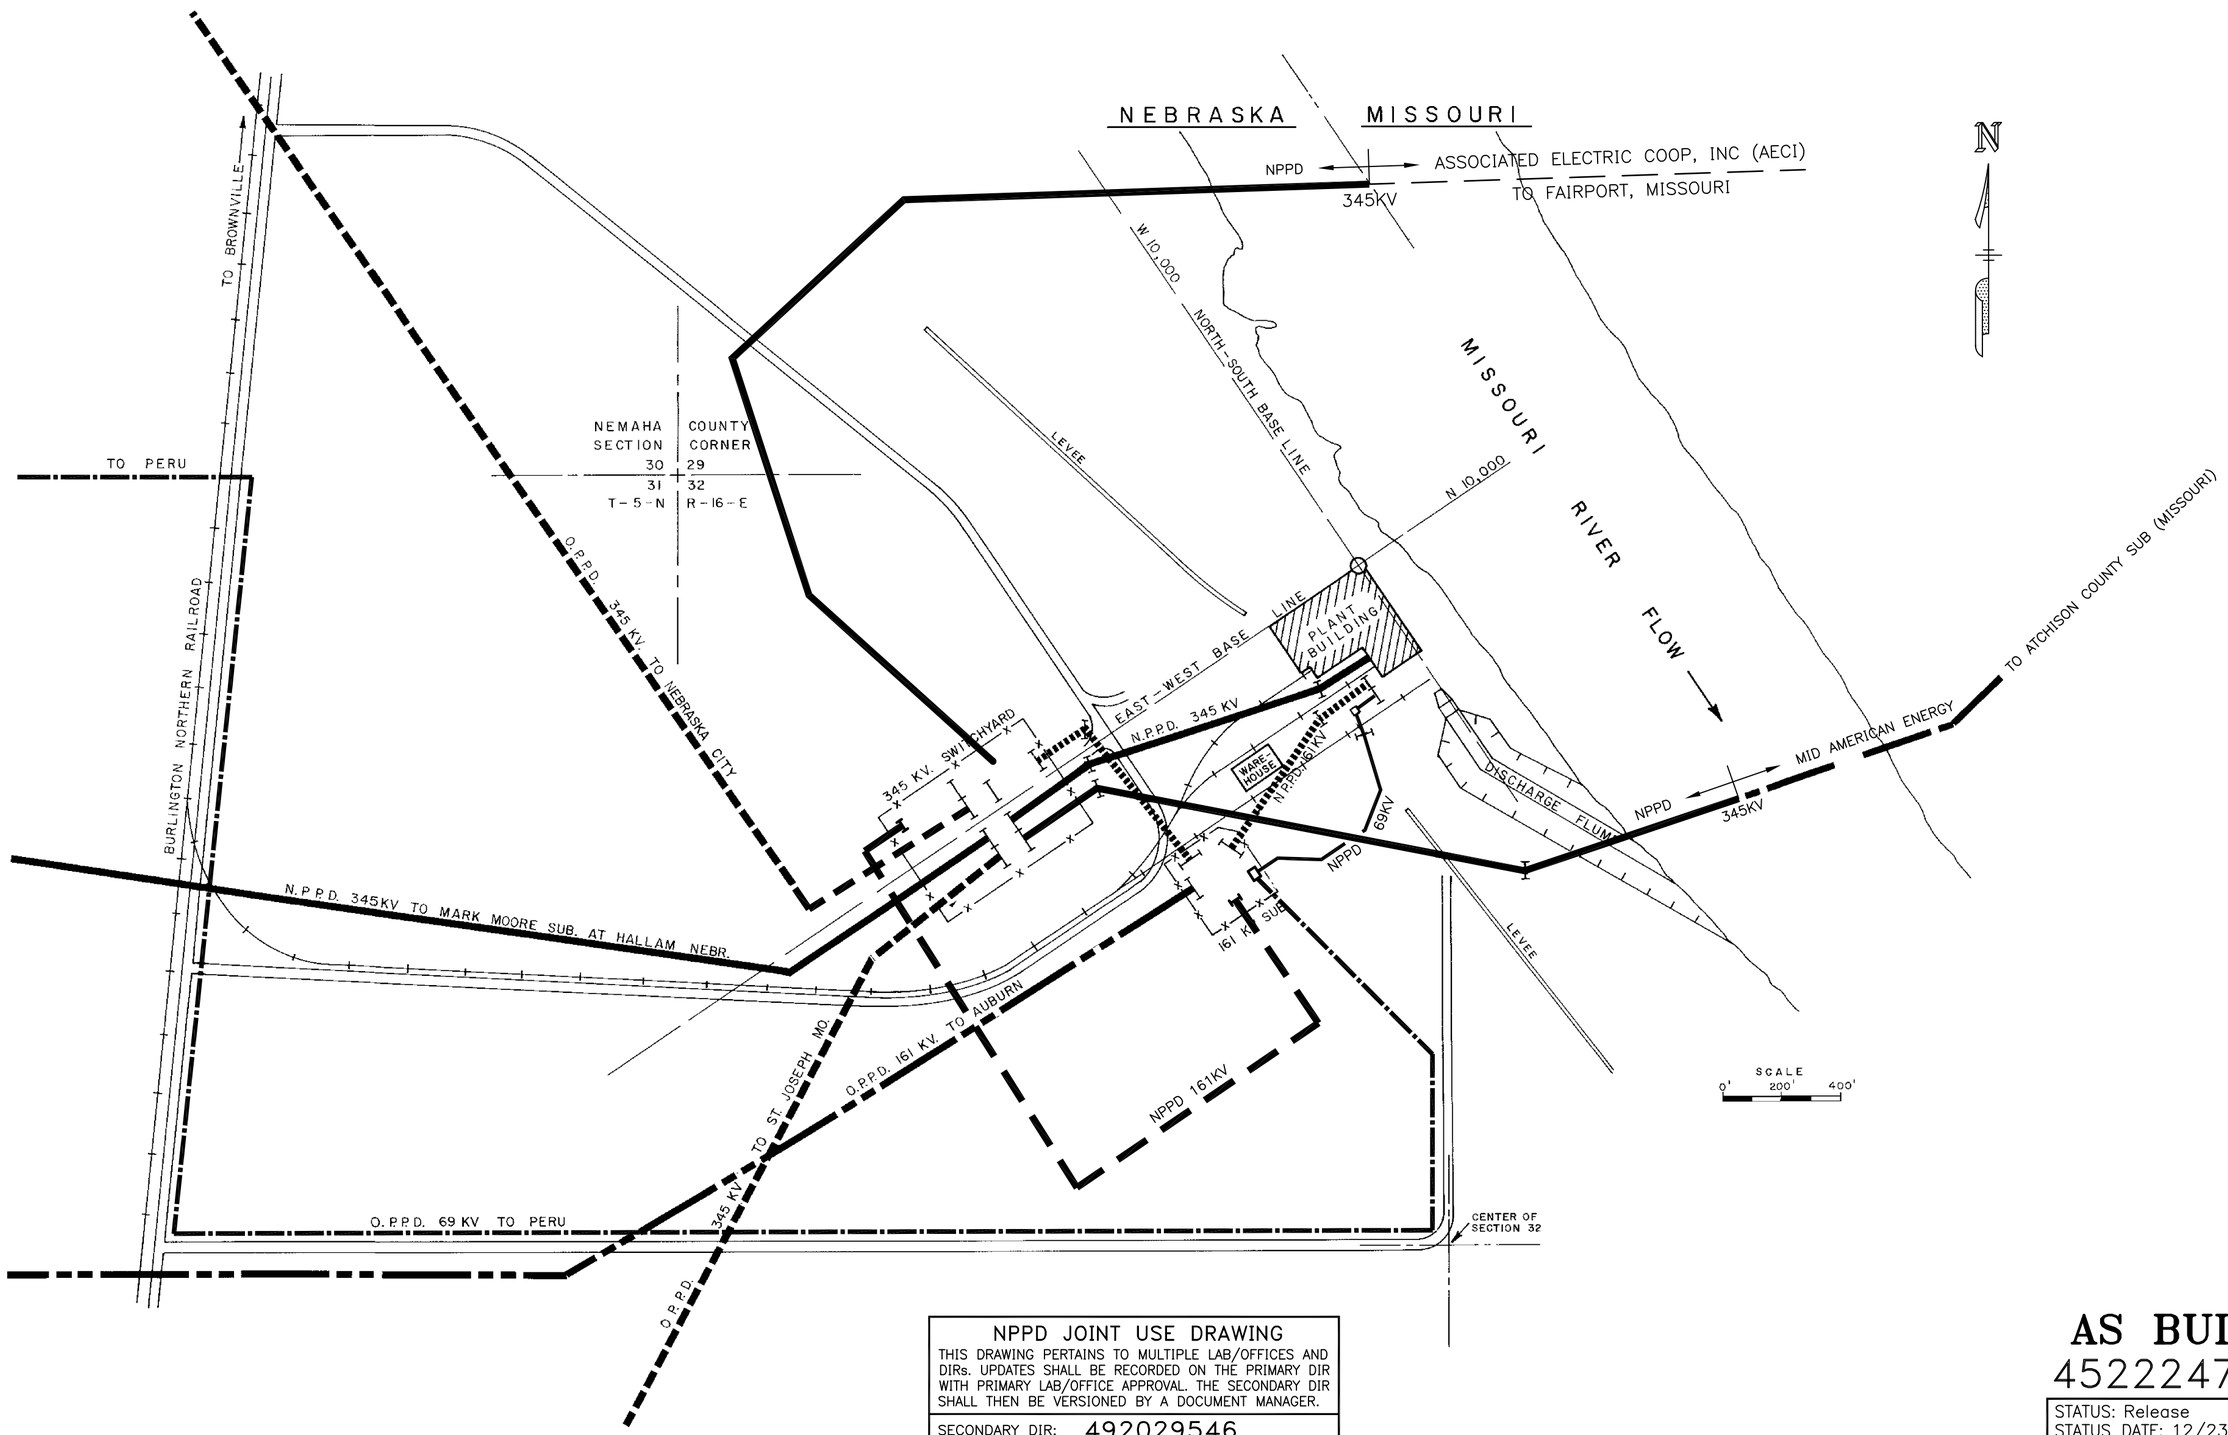

NPPD JOINT USE DRAWING

THIS DRAWING PERTAINS TO MULTIPLE LAB/OFFICES AND DIRs. UPDATES SHALL BE RECORDED ON THE PRIMARY DIR WITH PRIMARY LAB/OFFICE APPROVAL. THE SECONDARY DIR SHALL THEN BE VERSIONED BY A DOCUMENT MANAGER.

SECONDARY DIR: 492029546

AS BUILT
452224749

STATUS: Release
STATUS DATE: 12/23/2014
DS APPROVED: JDWILSO
VER: AB REV: 02 SIZE: C

FOR PREVIOUS REVISIONS, SEE SUPERSEDED CARDS.

VERSIONS/REVISIONS BY N.P.P.D.

NO.	DESCRIPTION	DFT	DATE	ENG
AB/02	DR-2014-0008	DLR	9/23/14	DJBUTLE

SIGNIFICANT NUMBER	035170 035010 035040 035000				7610	
GROUP	1	2	3	4	5	6

COOPER NUCLEAR STATION
TRANSMISSION LINE ROUTES

DRAWN	DATE
RAC	5/10/00
CHECKED	DATE
APPROVED	DATE
SEE SUPERSEDED CARDS	
FILMED	

Nebraska Public Power District

NC29546

CADD FILE: E0029807

NO. VERSIONS/REVISIONS