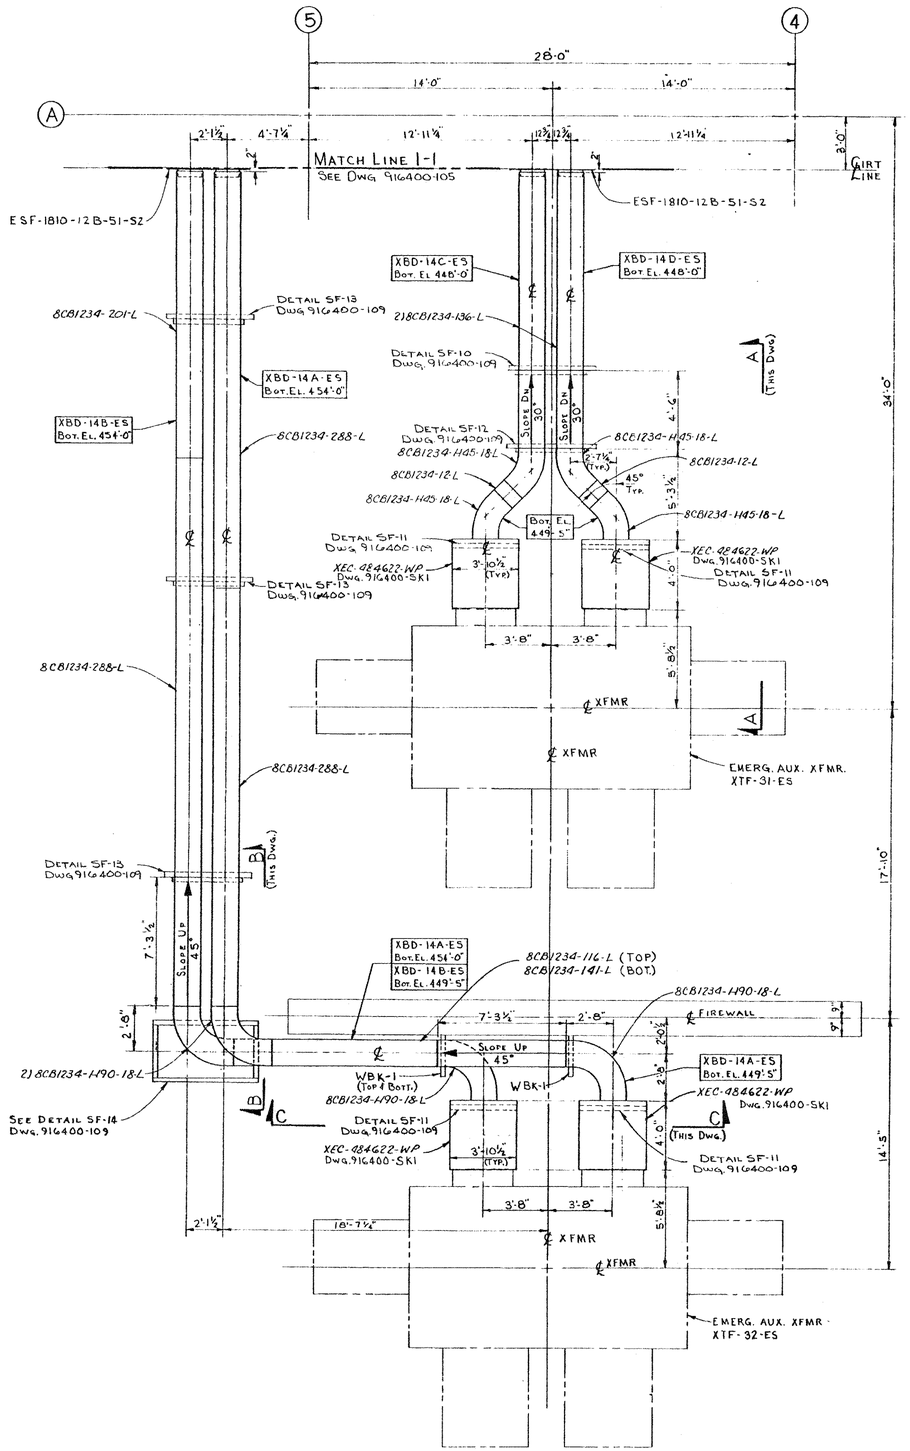

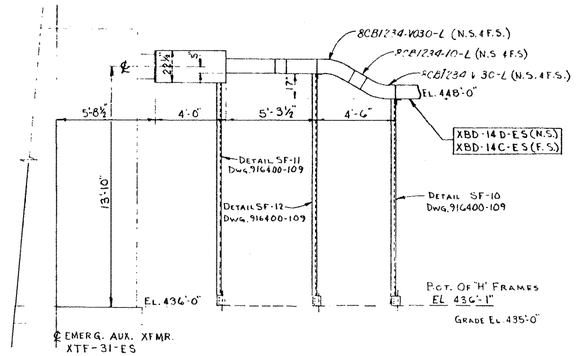

SECTION "A-A"

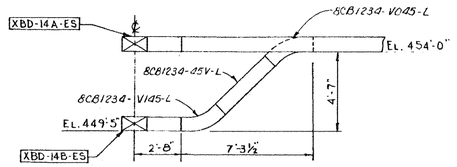

SECTION "B-B"

SEE DWG. 916400-108 FOR ANCHOR BOLT PLAN

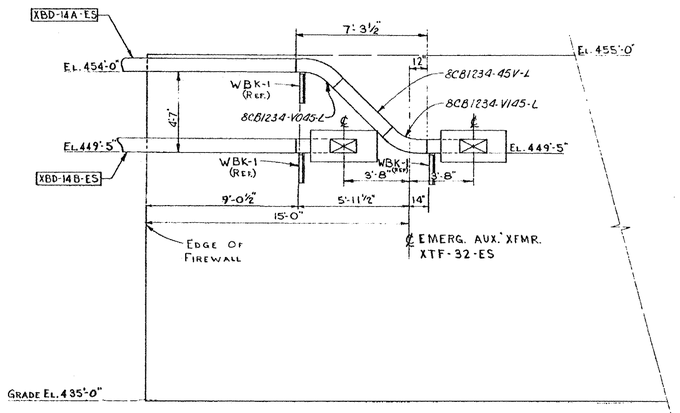

SECTION "C-C"

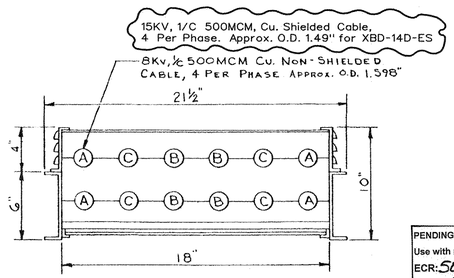

2000A 8Kv 3Ø-3W SYSTEM
CATALOG NO. 8CB1234-( )-L

OUTDOOR CABL-BUS CROSS SECTION

APPROX. WT. PER FT. 44 LBS.

SOUTH CAROLINA ELECTRIC & GAS CO.
VIRGIL C. SUMMER NUCLEAR STATION UNIT No. 1

☒ APPROVED
☐ APPROVED AS NOTED
☐ RETURNED FOR CORRECTION

CHECKING IS ONLY FOR GENERAL DESIGN AND GENERAL DIMENSIONS SET FORTH IN CONTRACT DOCUMENTS AND DOES NOT RELIEVE CONTRACTOR FROM HIS OBLIGATON AS TO DETAIL WORKMANSHIP AND GUARANTEES.

GILBERT ASSOCIATES, INC.
BY R.T. STRAUSSER
B/M ITEM No. ED-1 DATE 5/19/77

PENDING/HOLD CHG
Use with reference to
ECR: 50757
DATE: 08/10/11
INITIALS: CNT

FSAR Figure 8.3-0

OUTDOOR CABLE BUS LAYOUT & SECTIONS
EMERGENCY AUXILIARY TRANSFORMER AREA

VENDOR/DRAWING NO. HUSKY PRODUCTS INC.
916400-100

DESIGN ENGINEERING
V. C. SUMMER NUCLEAR STATION JENKINSVILLE, S. C.

NO.	DATE	BY	REVISION	CKD. BY	LE APPROVAL
4	08/18/17	JTS	REVISED PER ECR-50919	AME	JRC
3	10/09/11	DDJ	REVISED PER ECR-70028	MGR	DDJ

MADE: DDJ | CHECKED: MGR | LE APPROVAL: DDJ

SCALE: NO SCALE
DRAWING NUMBER: 1MS-33-007
SHT. NUMBER: 4
REV

1/4"=1'-0"
0' 5' 10' 15' 20'