


- NOTES:
- OFFGAS SYSTEM SHOWN IN OPERATING CONDITION WITH SYSTEM "A" SELECTED
    - ⊕ VALVES & CONTROLS FOR SYSTEM "A" ARE ENERGIZED.
    - ⊖ VALVES & CONTROLS FOR SYSTEM "B" ARE DE-ENERGIZED (FAIL-SAFE POSITION)
  - CHARCOAL TANK VALVES ARE SHOWN IN PARALLEL OPERATION WITH BYPASS CLOSED (ALL VALVES ARE DE-ENERGIZED (FAIL-SAFE POSITION)).
  - FOR STATE POINT CONDITIONS SEE PROCESS FLOW DIAGRAM DWG 6000304.
  - INSTRUMENTATION SYMBOLS FROM ISA STD.
  - ALL COMPONENTS SHOWN ON THIS DRAWING ARE PART OF AOG SYSTEM UNLESS NOTED OTHERWISE.
  - FOR QUALITY GROUP CLASSIFICATIONS AND QUALITY ASSURANCE PROVISIONS REFER TO MDC 83-54.
  - OILER/FILTER STATIONS MAY NOT BE SHOWN. INSTALLATION OF OILER/FILTER STATIONS HAS BEEN EVALUATED BY EE 03-080.
  - FIC-2038 FLOW INDICATION FUNCTION SHOWN ON DWG 2035 SH 1.
  - AOG-LUB-936AV REMOVED PER CC-5347407.

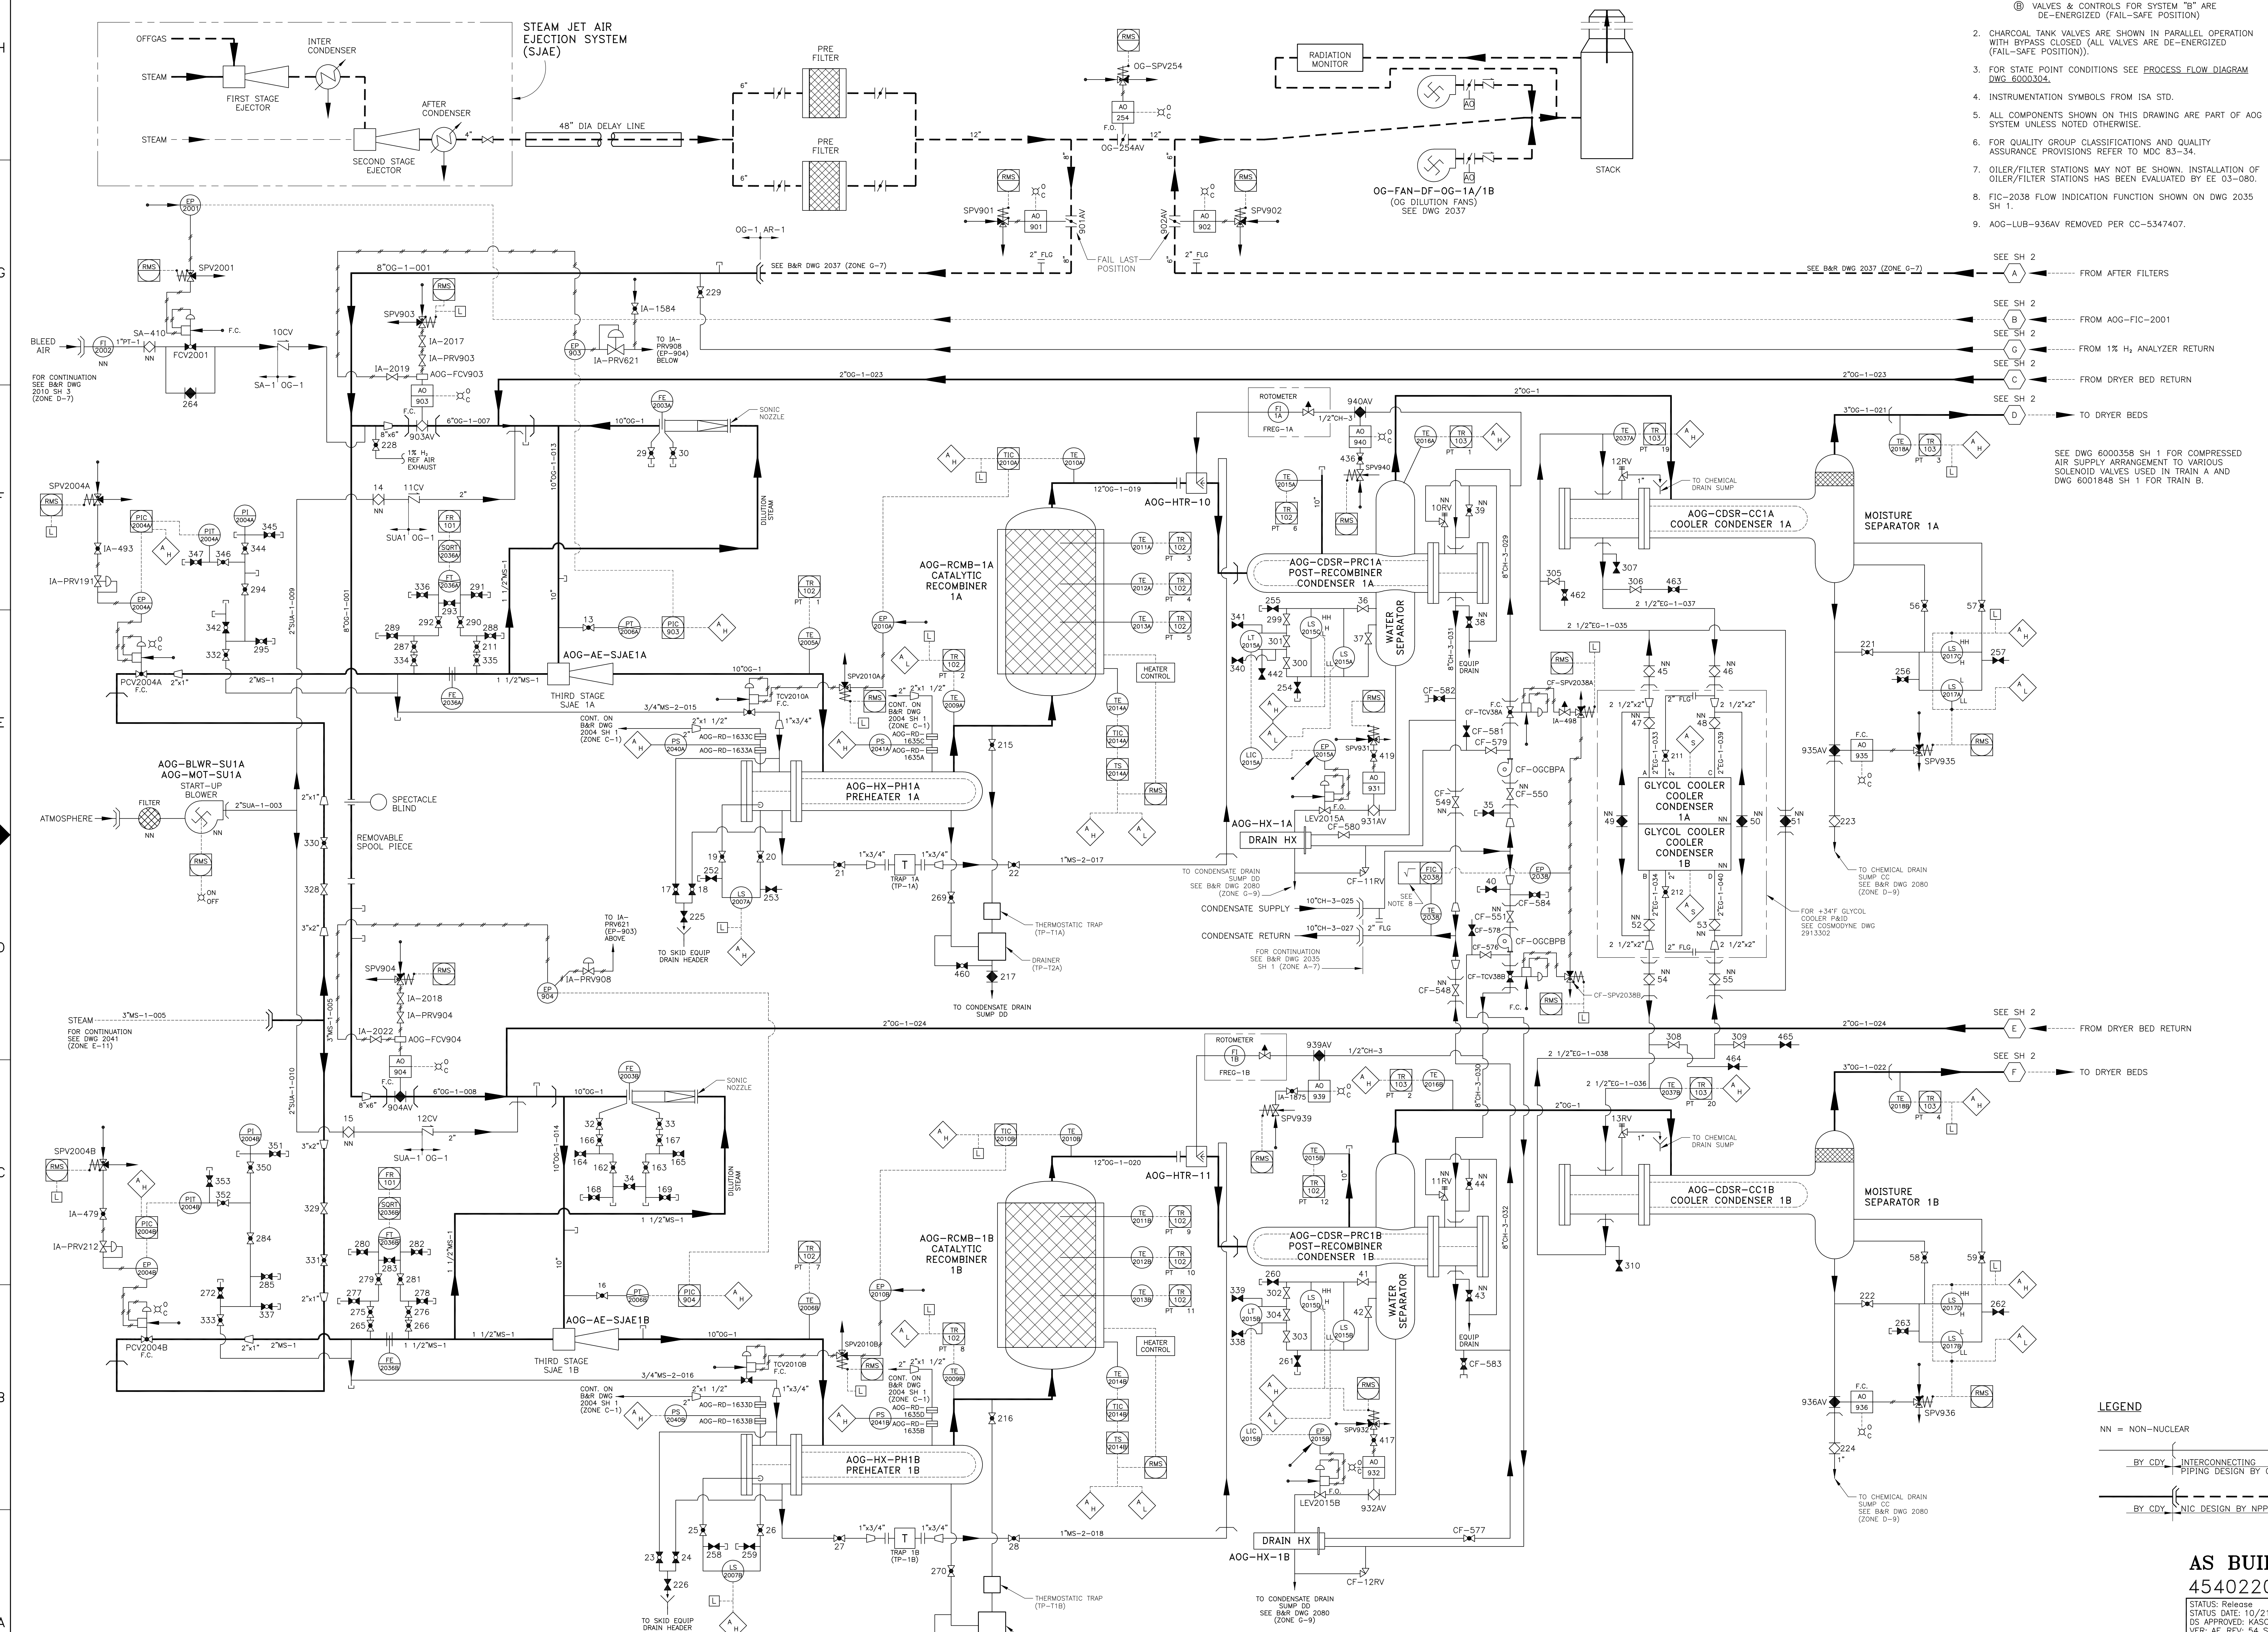

SEE SH 2 FROM AFTER FILTERS  
 SEE SH 2 FROM AOG-FIC-2001  
 SEE SH 2 FROM 1% H<sub>2</sub> ANALYZER RETURN  
 SEE SH 2 FROM DRYER BED RETURN  
 SEE SH 2 TO DRYER BEDS

SEE DWG 600035B SH 1 FOR COMPRESSED AIR SUPPLY ARRANGEMENT TO VARIOUS SOLENOID VALVES USED IN TRAIN A AND DWG 600184B SH 1 FOR TRAIN B.

TO CHEMICAL DRAIN SUMP  
 TO CHEMICAL DRAIN SUMP CC SEE BAR DWG 2080 (ZONE D-9)  
 FOR +34°F GLYCOL COOLER F&ID SEE COSMOZYNE DWG 2913302

TO CONDENSATE DRAIN SUMP DD SEE BAR DWG 2080 (ZONE G-9)  
 CONDENSATE SUPPLY  
 CONDENSATE RETURN  
 FOR CONTINUATION SEE BAR DWG 2035 SH 1 (ZONE A-7)

TO CONDENSATE DRAIN SUMP DD  
 TO SKID EQUIP DRAIN HEADER  
 TO CONDENSATE DRAIN SUMP DD  
 TO SKID EQUIP DRAIN HEADER


**LEGEND**  
 NN = NON-NUCLEAR  
 --- BY CDY INTERCONNECTING PIPING DESIGN BY CDY  
 --- BY CDY NIC DESIGN BY NPPD

**AS BUILT**  
 454022076  
 STATUS: Release  
 STATUS DATE: 10/21/2021  
 DS APPROVED: KASCHIZ  
 VER: AF REV: 54 SIZE: E

| VERSIONS/REVISIONS BY NPPD |  |          |      |      | DRAWN DATE |      |
|----------------------------|--|----------|------|------|------------|------|
| NO.                        | DESCRIPTION  | ORDER/DT | DATE | ENG. | CHECKED    | DATE |
| AW/05/09-2014-0008         | 83-0410R1/2/3/4/5 (AS BUILT)   |          |      |      |            |      |
| AW/05/09-2017-0001         | 08B57/7/8 (AS BUILT)   |          |      |      |            |      |
| AW/05/09-2020-0031         | 5347407/05/23/24/25/99/100          |          |      |      |            |      |
| AW/05/09-2021-0001         | 08B19/20/21 (AS BUILT)   |          |      |      |            |      |
| AW/05/09-2020-0031         | 5347407/08/19/21/22/23/99/100 |          |      |      |            |      |

|                         |  |  |  |  |  |               |  |
|-------------------------|--|--|--|--|--|---------------|--|
| COOPER NUCLEAR STATION  |  |  |  |  |  | DRAWN DATE    |  |
| P & I DIAGRAM           |  |  |  |  |  | CHECKED DATE  |  |
| AUGMENTED OFFGAS SYSTEM |  |  |  |  |  | APPROVED DATE |  |
| 6000302 SH 1            |  |  |  |  |  | FILMED        |  |
| COSMODYNE               |  |  |  |  |  | DATE          |  |
| 6000302 SH 1            |  |  |  |  |  | DATE          |  |