


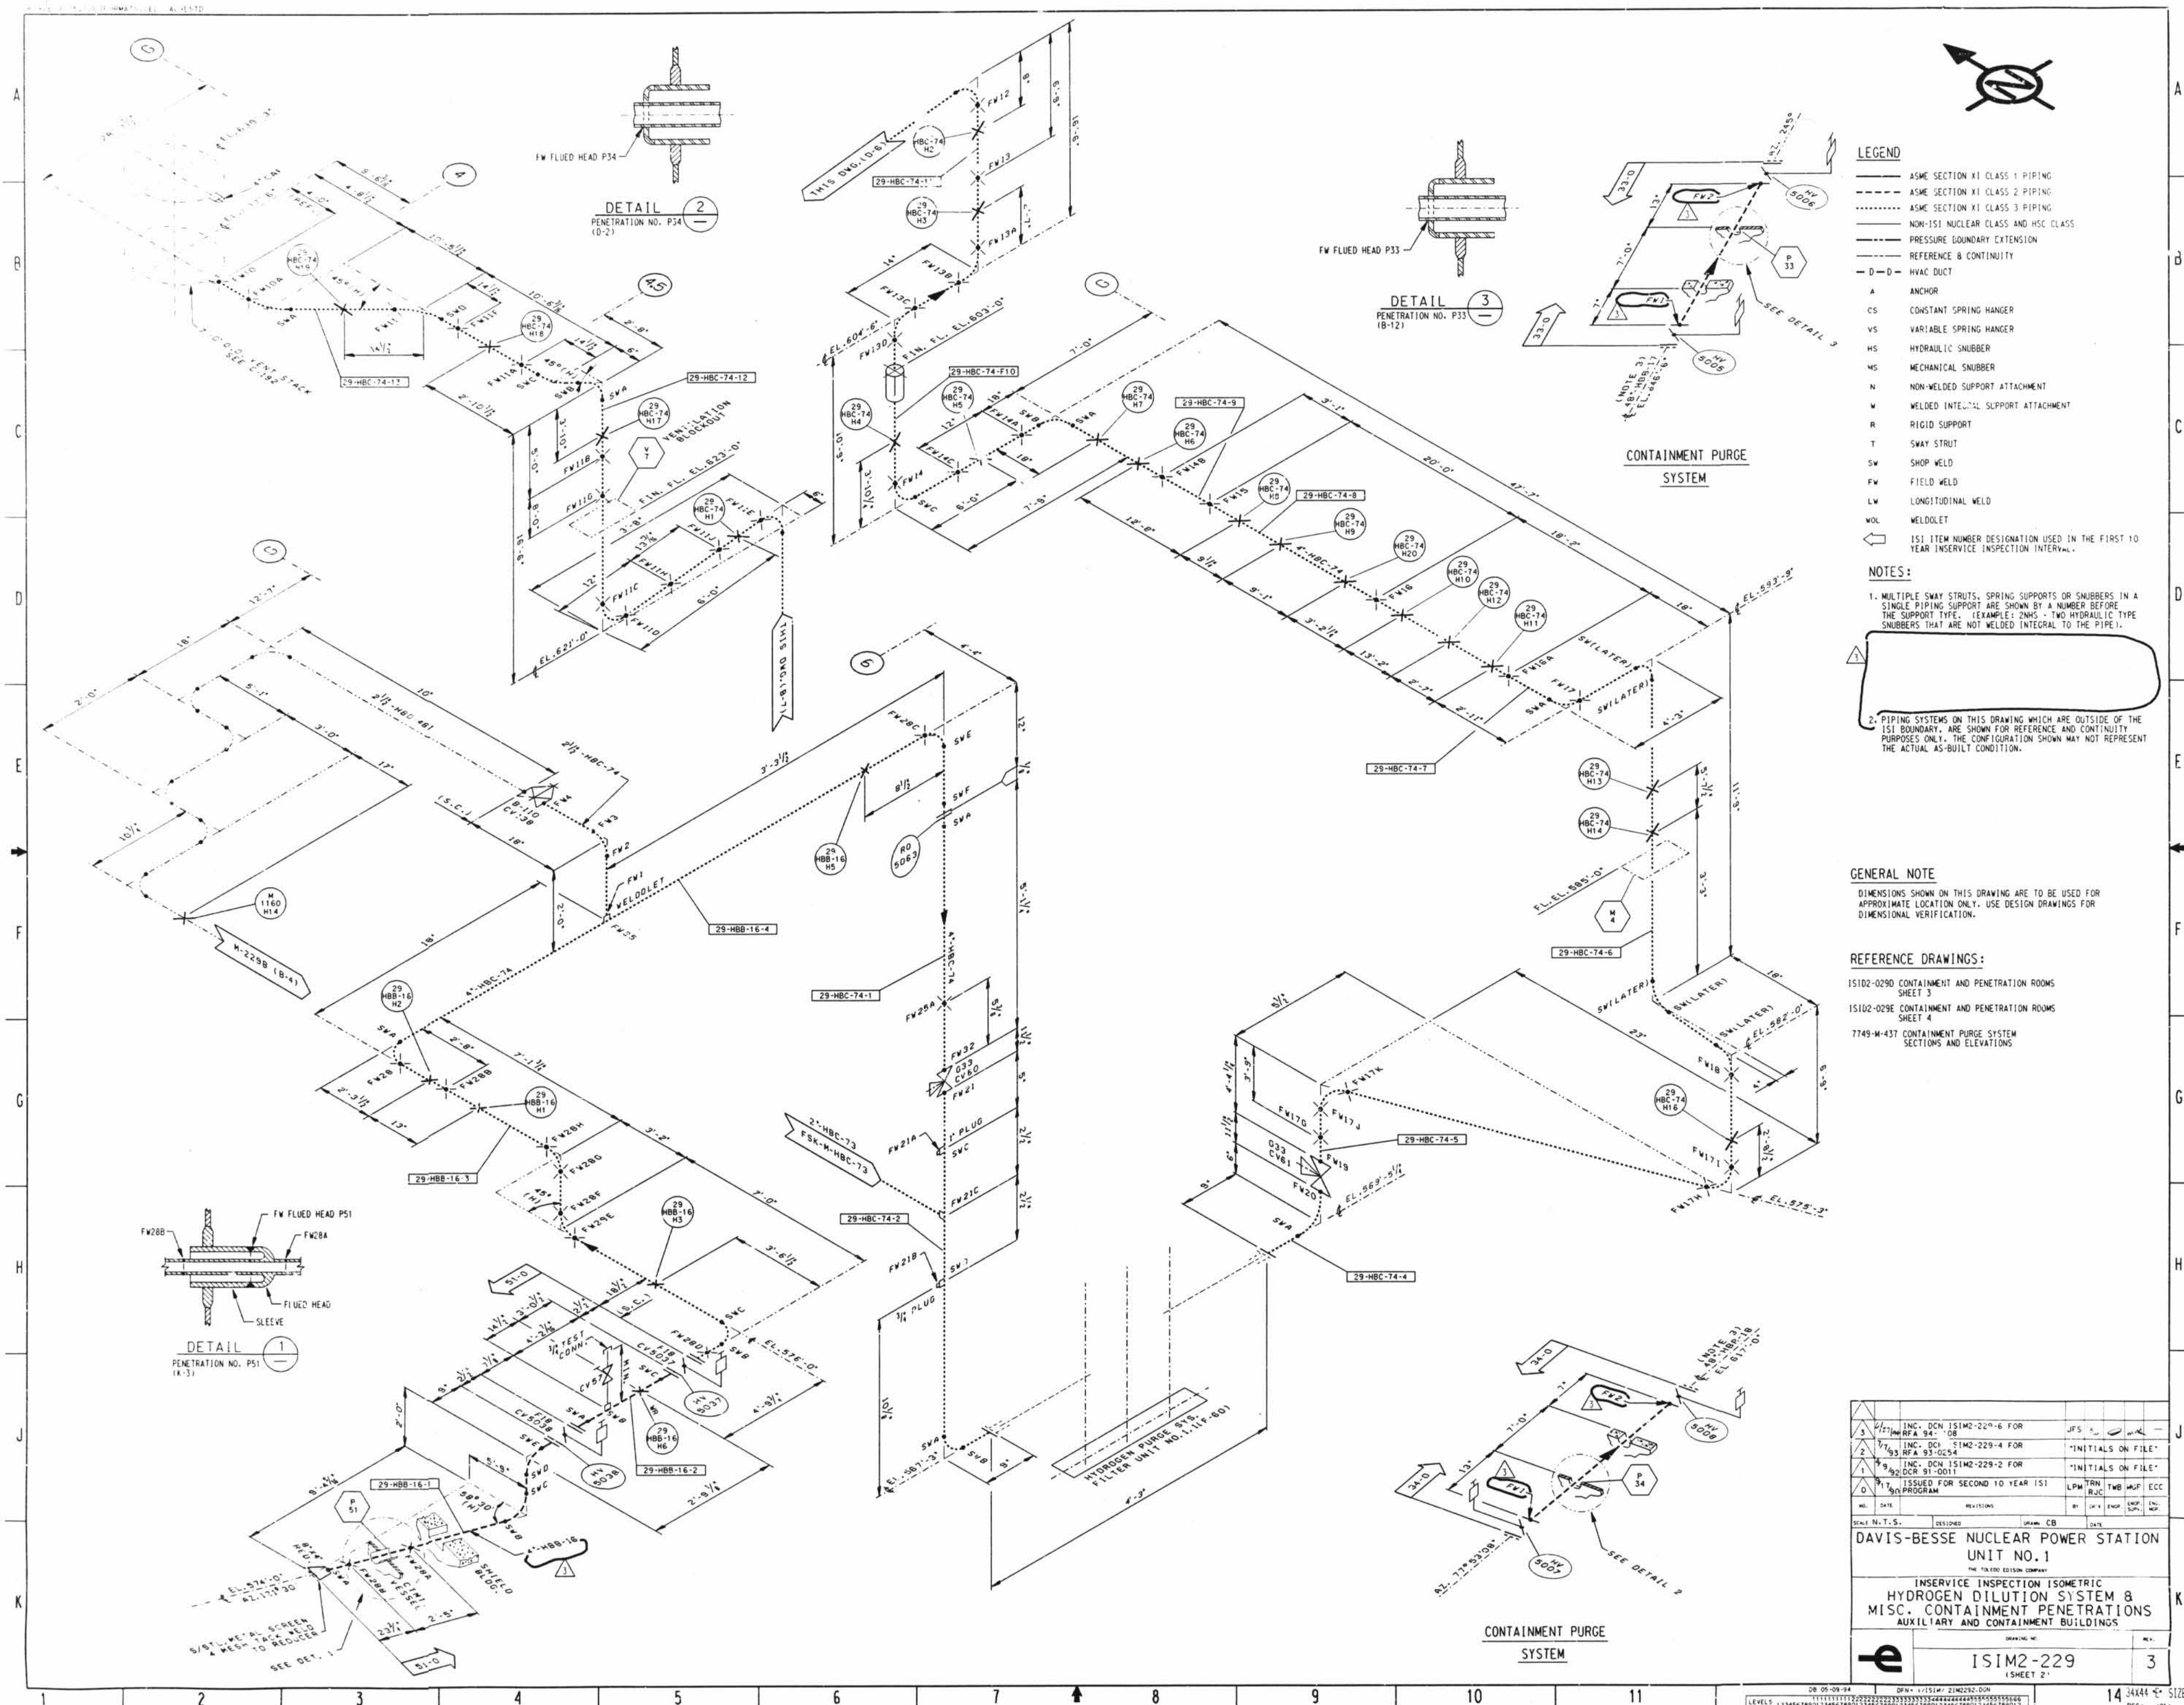

- LEGEND**
- ASME SECTION XI CLASS 1 PIPING
 - ASME SECTION XI CLASS 2 PIPING
 - ASME SECTION XI CLASS 3 PIPING
 - NON-ISI NUCLEAR CLASS AND HSC CLASS
 - PRESSURE BOUNDARY EXTENSION
 - REFERENCE & CONTINUITY
 - HVAC DUCT
 - ANCHOR
 - CONSTANT SPRING HANGER
 - VARIABLE SPRING HANGER
 - HYDRAULIC SNUBBER
 - MECHANICAL SNUBBER
 - NON-WELDED SUPPORT ATTACHMENT
 - WELDED INTEGRAL SUPPORT ATTACHMENT
 - RIGID SUPPORT
 - SWAY STRUT
 - SHOP WELD
 - FIELD WELD
 - LONGITUDINAL WELD
 - WELDLET
 - ISI ITEM NUMBER DESIGNATION USED IN THE FIRST 10 YEAR INSERVICE INSPECTION INTERVAL
- NOTES:**
- MULTIPLE SWAY STRUTS, SPRING SUPPORTS OR SNUBBERS IN A SINGLE PIPING SUPPORT ARE SHOWN BY A NUMBER BEFORE THE SUPPORT TYPE. (EXAMPLE: 2MS - TWO HYDRAULIC TYPE SNUBBERS THAT ARE NOT WELDED INTEGRAL TO THE PIPE).
 - PIPING SYSTEMS ON THIS DRAWING WHICH ARE OUTSIDE OF THE ISI BOUNDARY, ARE SHOWN FOR REFERENCE AND CONTINUITY PURPOSES ONLY. THE CONFIGURATION SHOWN MAY NOT REPRESENT THE ACTUAL AS-BUILT CONDITION.
- GENERAL NOTE**
- DIMENSIONS SHOWN ON THIS DRAWING ARE TO BE USED FOR APPROXIMATE LOCATION ONLY. USE DESIGN DRAWINGS FOR DIMENSIONAL VERIFICATION.
- REFERENCE DRAWINGS:**
- 15102-0290 CONTAINMENT AND PENETRATION ROOMS SHEET 3
 - 15102-0298 CONTAINMENT AND PENETRATION ROOMS SHEET 4
 - 7749-M-437 CONTAINMENT PURGE SYSTEM SECTIONS AND ELEVATIONS
- | REV | DATE | REVISIONS | BY | CHKD | APPD |
|-----|----------|------------------------------------|----|------|------|
- DAVIS-BESSE NUCLEAR POWER STATION
UNIT NO. 1
INSERVICE INSPECTION ISOMETRIC
HYDROGEN DILUTION SYSTEM 8
MISC. CONTAINMENT PENETRATIONS
AUXILIARY AND CONTAINMENT BUILDINGS
- ISIM2-229
SHEET 2

I CERTIFY THAT THE IMAGE CONTAINED ON THIS FRAME WAS MADE IN THE NORMAL AND REGULAR COURSE OF BUSINESS, ON THE DATE STATED BELOW AND THAT IT IS AN ACCURATE REPRESENTATION OF THE PROPERTY SUBMITTED TO SUCH RECORDS MANAGEMENT.

6-27-94

D-6